



County of Siskiyou

GENERAL SERVICES

190 GREENHORN ROAD
YREKA, CA 96097
530.842.8220 530.841.2800 FAX

September 27, 2023

ADDENDUM NO. 1

FOR CONSTRUCTION PROJECT FIRST ADVERTISED ON JUNE 12, 2023

FOR CONSTRUCTION ON
SISKIYOU COUNTY GENERAL SERVICES
BOARD OF SUPERVISORS CHAMBERS REMODEL
AT 311 FOURTH STREET, YREKA, CA
Contract No. 23-107010-02

*****BID OPENING ON MONDAY, OCTOBER 2, 2023 AT 3:00 P.M.*****

TO ALL BIDDERS:

The original work plan is hereby supplemented by this Addendum No. 1. This Addendum applies to all phases of the work and supersedes anything in the contract documents with which it may conflict. Please make the following revisions to the work plan for the above project.

BIDDERS SHALL ACKNOWLEDGE receipt of this Addendum by inserting its number into the space provided on Page 1 of Section 00 41 00, "Bid Form" of the Contract Book. Failure to do so may subject bidders to disqualification.

SPECIFICATIONS AND DRAWINGS:

A. CHANGES TO CONTRACT BOOK

- a. Removed Section 08 11 00 – Metal Doors and Frames

B. CHANGES TO DRAWINGS

- a. A100 – Added Keynote #17 to remove existing furred wood strip
- b. A220 – Added Keynote #14 to add gypsum board where furred wood strip was removed
- c. A500 – Revised tall cabinet elevation, see 1A/A500
- d. A500 – Revised wood paneling to Plastic Laminate in Legend
- e. A501 – Revised wood paneling to Plastic Laminate in Legend
- f. A710 – Added Door frame elevation

- g. A901 – Revised 2x6 floor joist to 2x4, see detail 5/A901
- h. A902 – Revised tall cabinet section door and soffit, see detail 4/A902
- i. A902 – Added penetration detail, see detail 11/A902
- j. A940 – Revised hard wood paneling to Plastic Laminate
- k. E2.0 – Added Data Drop in Power Closet
- l. E2.0 – Added Keynote #6, to locate electrical within the Power Closet.

C. **RFI RESPONSES** - See attached table of bid questions / responses.

Any questions should be directed to Amanda Kimball at (530) 842-8220 or akimball2@co.siskiyou.ca.us

Sincerely,




JOY HALL, Director of General Services

AVC/SA/ldr

Attachments:


Attachment 1 BID RFI Log with responses. (1 page, 8 ½ x 11)

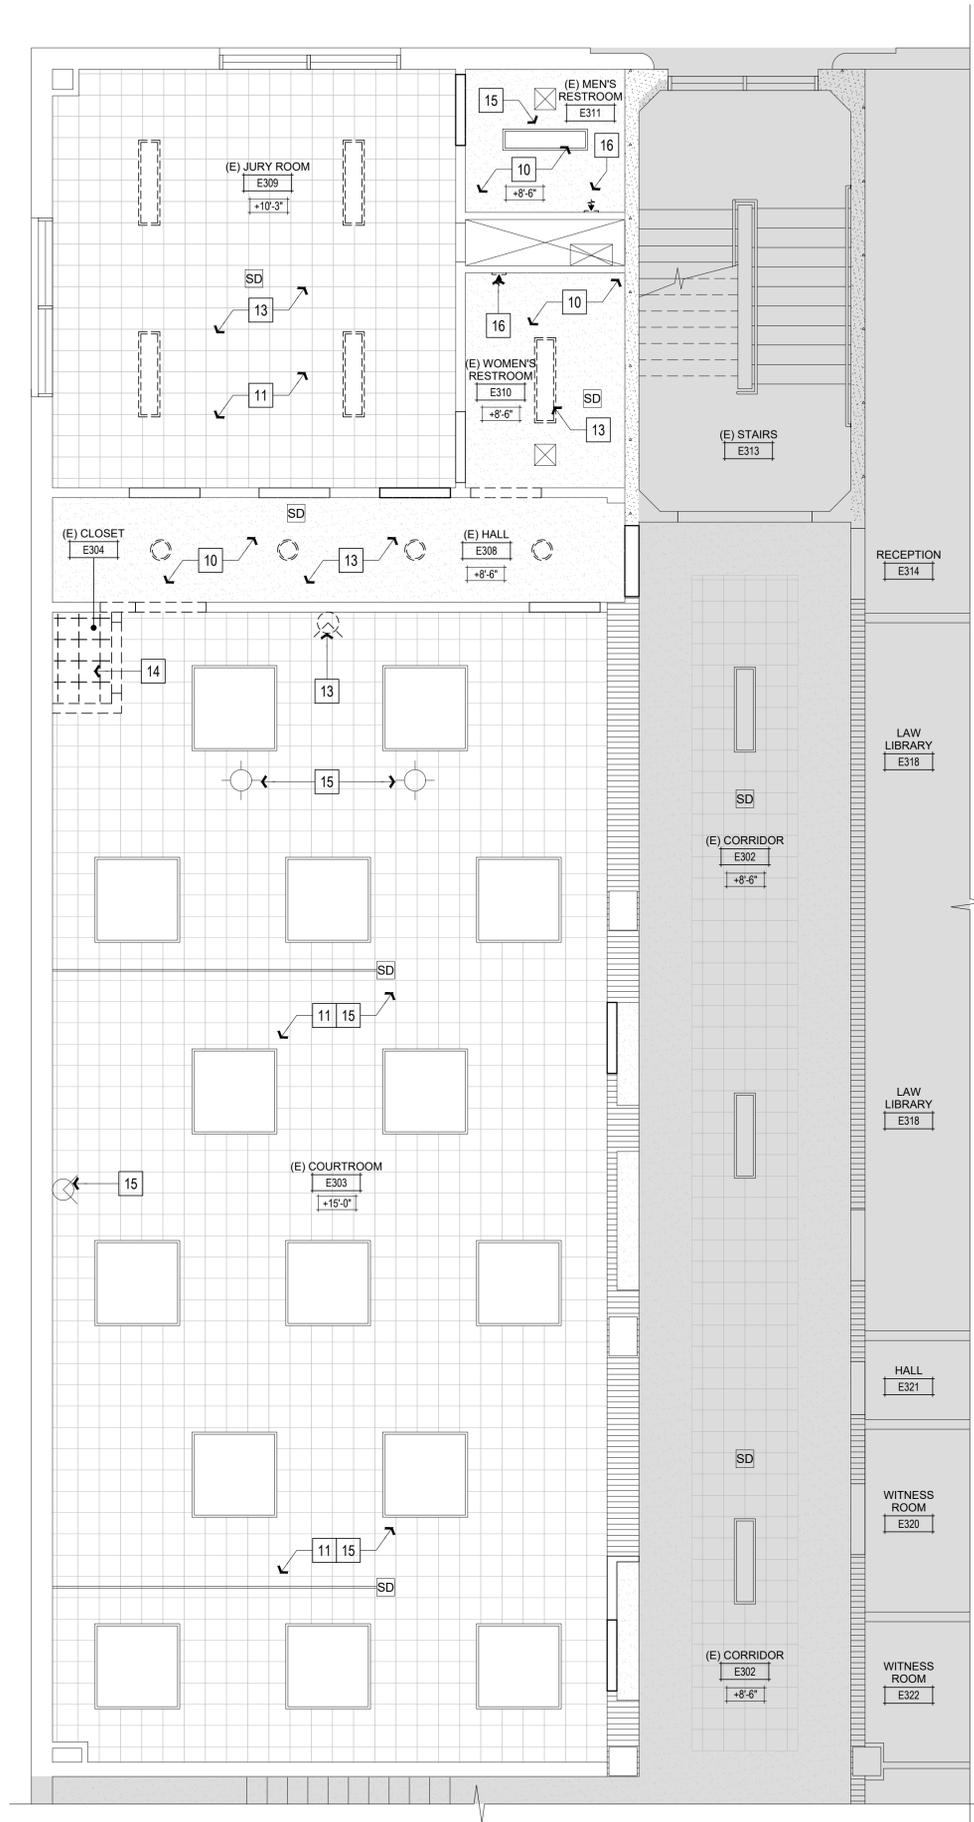

DEMOLITION RCP

2

SCALE: 1/4" = 1'-0"

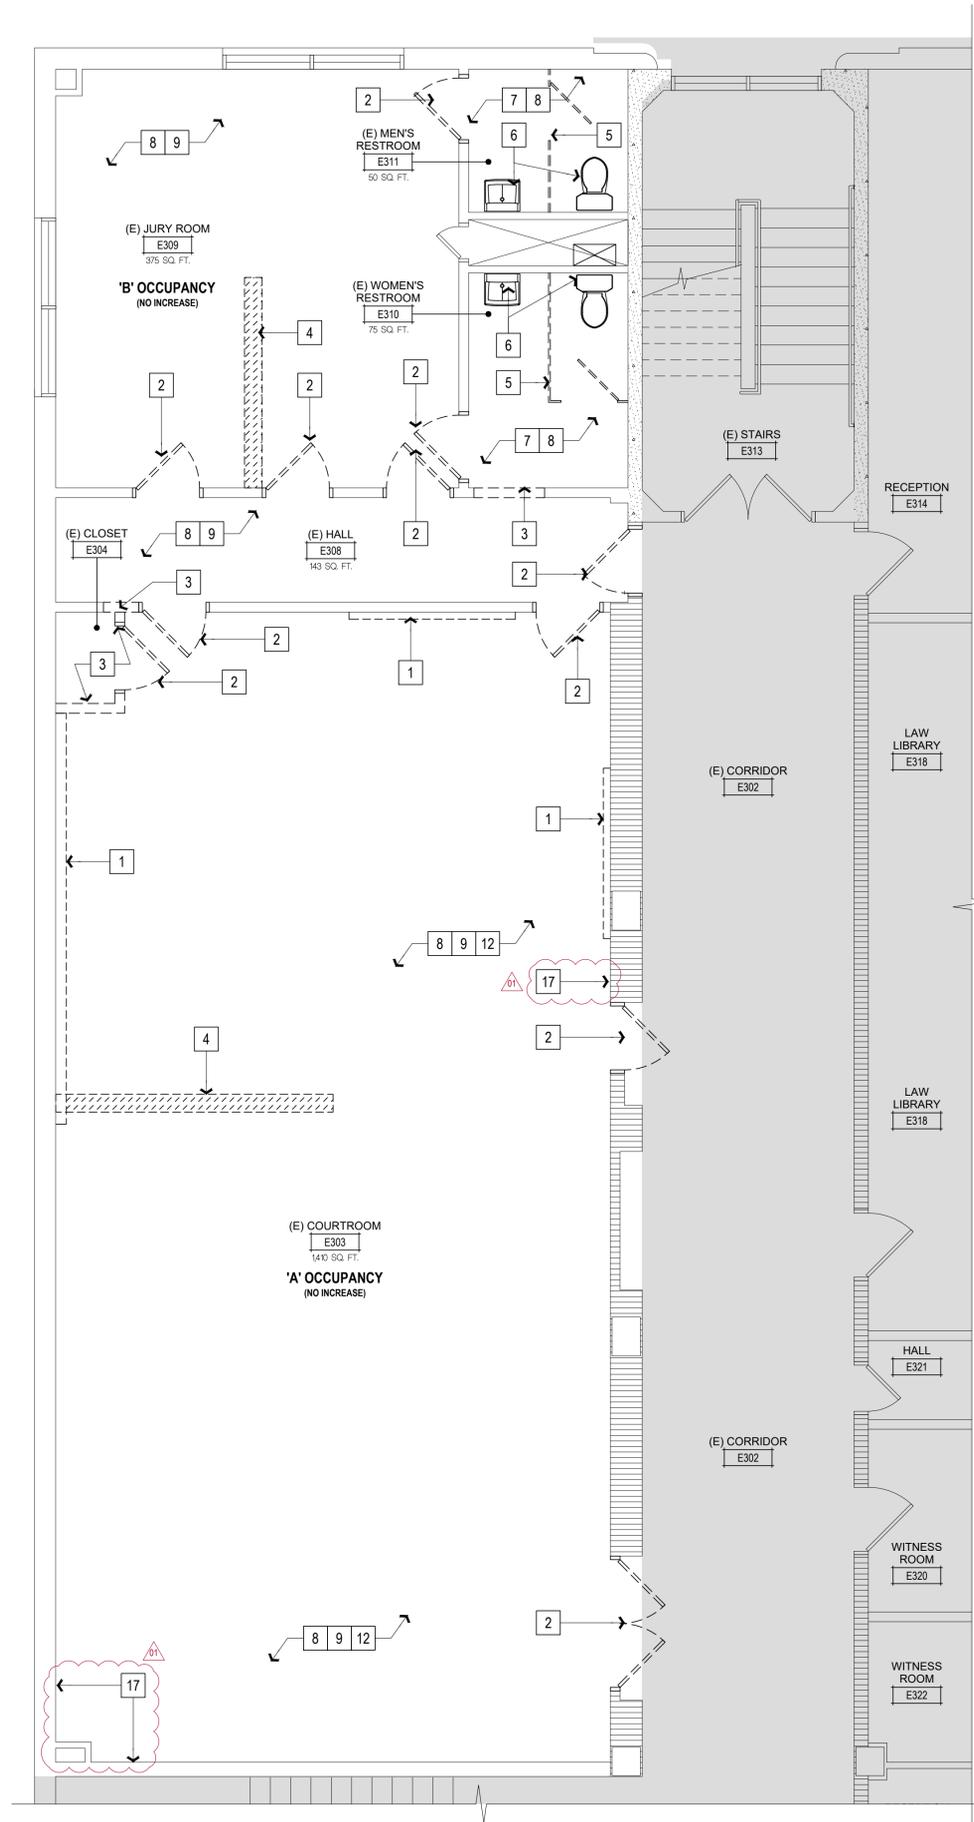

DEMOLITION FLOOR PLAN

1

SCALE: 1/4" = 1'-0"

GEN. DEMOLITION NOTES

- REQUIRED EXITS SHALL BE MAINTAINED WHEN TEMPORARY CONSTRUCTION BARRIERS ARE PROVIDED.
- CONTRACTOR SHALL FIELD VERIFY ALL EXISTING CONSTRUCTION RELATED CONDITIONS PRIOR TO STARTING DEMOLITION.
- ALL DEMOLITION AND CONSTRUCTION ACTIVITIES SHALL BE COORDINATED WITH THE OWNERS REPRESENTATIVE TO MINIMIZE DISRUPTION OF THE NORMAL DAILY FUNCTIONS OF THE OCCUPIED AREAS.
- CONTRACTOR SHALL TAKE ALL NECESSARY PRECAUTIONS TO PREVENT DAMAGE TO OWNER OCCUPIED AREAS ADJACENT TO NEW CONSTRUCTION OR OCCUPIED AREAS WHERE VARIOUS SYSTEM CONNECTIONS OR EXTENSIONS ARE REQUIRED, AND IS RESPONSIBLE FOR DAMAGES CAUSED.
- THE OWNER WILL RETAIN ALL SALVAGE THAT IS OF VALUE AS DESIGNATED BY THE OWNERS REPRESENTATIVE. THE OWNERS REPRESENTATIVE WILL DIRECT THE CONTRACTOR AS TO THE LOCATION OF STORAGE AREAS FOR VARIOUS ITEMS. THE CONTRACTOR SHALL BE RESPONSIBLE FOR THE REMOVAL FROM THE CONSTRUCTION SITE OF ALL CONSTRUCTION DEBRIS, AND/OR ITEMS NOT RETAINED BY THE OWNERS REPRESENTATIVE.
- TEMPORARY BARRICADES AS PERTAINING TO THE CONTRACTORS ACTIVITIES, SHALL BE INSTALLED TO PREVENT POSSIBLE INJURY TO PERSONS IN AND AROUND DEMOLITION AND CONSTRUCTION AREAS. COORDINATE WITH OWNERS REPRESENTATIVE.
- DUST PARTITIONS WILL BE INSTALLED BY THE CONTRACTOR. PARTITIONS MUST BE IN ACCORDANCE WITH FIRE PROTECTION AND EGRESS REQUIREMENTS.
- WHERE REMOVAL OF FLOOR COVERINGS AND VINYL WALL BASE ARE REQUIRED, REMOVE ONLY WHAT IS NECESSARY TO COMPLETE DEMOLITION. DEMOLITION INCLUDES REMOVAL OF ADHESIVES, GROUTING BEDS, ETC., AND REQUIRES REMAINING SURFACES TO BE PREPARED FOR NEW CONSTRUCTION.
- ANY AND ALL DISCREPANCIES IN THE DRAWINGS SHALL BE BROUGHT TO THE IMMEDIATE ATTENTION OF THE OWNERS REPRESENTATIVE.
- NOISE DURING DEMOLITION AND CONSTRUCTION SHALL BE KEPT TO A MINIMUM.
- ALL EXISTING SERVICES AND UTILITIES SHALL BE MAINTAINED TO ADJACENT DEPARTMENTS AND AREAS IN OPERATION. ANY TEMPORARY INTERRUPTION IN SERVICES SHALL BE PRIOR COORDINATED WITH OWNERS REPRESENTATIVE.
- ALL EXISTING ITEMS SUCH AS EQUIPMENT, PLUMBING, FIXTURES, ETC. TO REMAIN IN PLACE SHALL BE PROTECTED FROM DIRT AND DAMAGE DURING DEMOLITION AND CONSTRUCTION.
- ALL AREAS TO REMAIN WHICH ARE DISRUPTED BY ANY DEMOLITION ARE TO BE PATCHED AND PREPARED FOR NEW WALL COVERING.
- ALL OPENING AND VOIDS LEFT BY THE REMOVAL OF EXISTING CONSTRUCTION, EQUIPMENT, PIPING DUCTS, ETC., SHALL BE PROPERLY SEALED TO MAINTAIN PROPER FIRE RATING IN WALL. PREPARE PATCHES TO RECEIVE NEW FINISHES AS REQUIRED.

DEMOLITION KEYNOTES

- REMOVE (E) OAK PLYWOOD PANELS, SHOWN DASHED
- REMOVE (E) DOOR AND (E) DOOR FRAME, SHOWN DASHED
- DEMO SECTION OF WALL, SHOWN DASHED
- REMOVE 10" +/- WIDE 1-1/2" DEEP STRIP OF TOPPING COMPOUND FOR ELECTRICAL CONDUIT, SHOWN DASHED. SEE MECHANICAL DRAWINGS FOR MORE INFORMATION
- REMOVE (E) TOILET ROOM PARTITIONS, SHOWN DASHED
- REMOVE (E) PLUMBING FIXTURES. SEE PLUMBING DRAWINGS FOR MORE INFORMATION
- REMOVE ALL (E) MOUNTED TOILET ROOM ACCESSORIES, PREPARE WALLS FOR NEW FINISHES
- PREPARE FLOORING FOR NEW FLOOR COVERING
- PREPARE WALL FOR NEW FINISHES
- PREPARE CEILING FOR NEW FINISHES
- REMOVE (E) DAMAGED AND/OR LOOSE ACOUSTICAL CEILING TILES, REPLACE WITH NEW AND MATCH ADJACENT FINISHES
- REMOVE (E) DAMAGED AND/OR LOOSE ACOUSTICAL WALL TILES, REPLACE WITH NEW AND MATCH ADJACENT FINISHES
- REMOVE (E) LIGHTING FIXTURES, SHOWN DASHED, SEE ELECTRICAL DRAWINGS FOR MORE INFORMATION
- REMOVE (E) CEILING, SHOWN DASHED
- (E) LIGHTING FIXTURE TO REMAIN, PROTECT IN-PLACE
- REMOVE (E) SIDE WALL GRILLE, SEE MECHANICAL DRAWINGS FOR MORE INFORMATION
- REMOVE (E) FURRED WOOD STRIP, WHERE OCCURS, SEE 10/A902

LEGEND

- NO WORK IN THIS AREA
- (E) NON-RATED PARTITION TO REMAIN
- (E) 1 HOUR RATED FIRE PARTITION TO REMAIN
- (E) 4'x4' LIGHT FIXTURE TO REMAIN, SEE ELECTRICAL DRAWINGS
- (E) 1'x4' LIGHT FIXTURES TO REMAIN, SEE ELECTRICAL DRAWINGS
- (E) SMOKE DETECTOR TO REMAIN



NICHOLS MELBURG & ROSSETTO
ARCHITECTS + ENGINEERS
 2455 Bennett Valley Rd., Ste. B303
 Santa Rosa, CA 95404
 (707) 536-2121 (530) 222-3538 Fax
 http://www.nmrdesign.com

REVISIONS

Delta	Description	Date
Δ/B	BID SET #2	09/06/2023
Δ/01	ADDENDUM #1	09/27/2023

If drawing is not 24" x 36" it is a reduced print

Copyright © 2023

All ideas, designs, arrangements and plans indicated or represented by this drawing are owned by, and the property of, NICHOLS MELBURG and ROSSETTO and were created, evolved and developed for use on, and in conjunction with, the specified project. None of such ideas, designs, arrangements or plans shall be used by, or disclosed to any person, firm or corporation in any capacity whatsoever without the written permission of NICHOLS MELBURG and ROSSETTO.

AGENCY APPROVAL

LICENSE STAMPS



PROJECT NAME

**B.O.S. CHAMBERS
 REMODEL
 FOR**



311 FOURTH STREET
 YREKA, CALIFORNIA, 96097

SHEET TITLE

**ENLARGED
 DEMOLITION FLOOR PLAN
 & RCP**


DRAWING STATUS

**CONSTRUCTION
 DOCUMENTS**


Drawn By	JR
Date Issued	05/18/2023
Scale	1/4" = 1'-0"
Project No.	22-6513

SHEET No.

A100

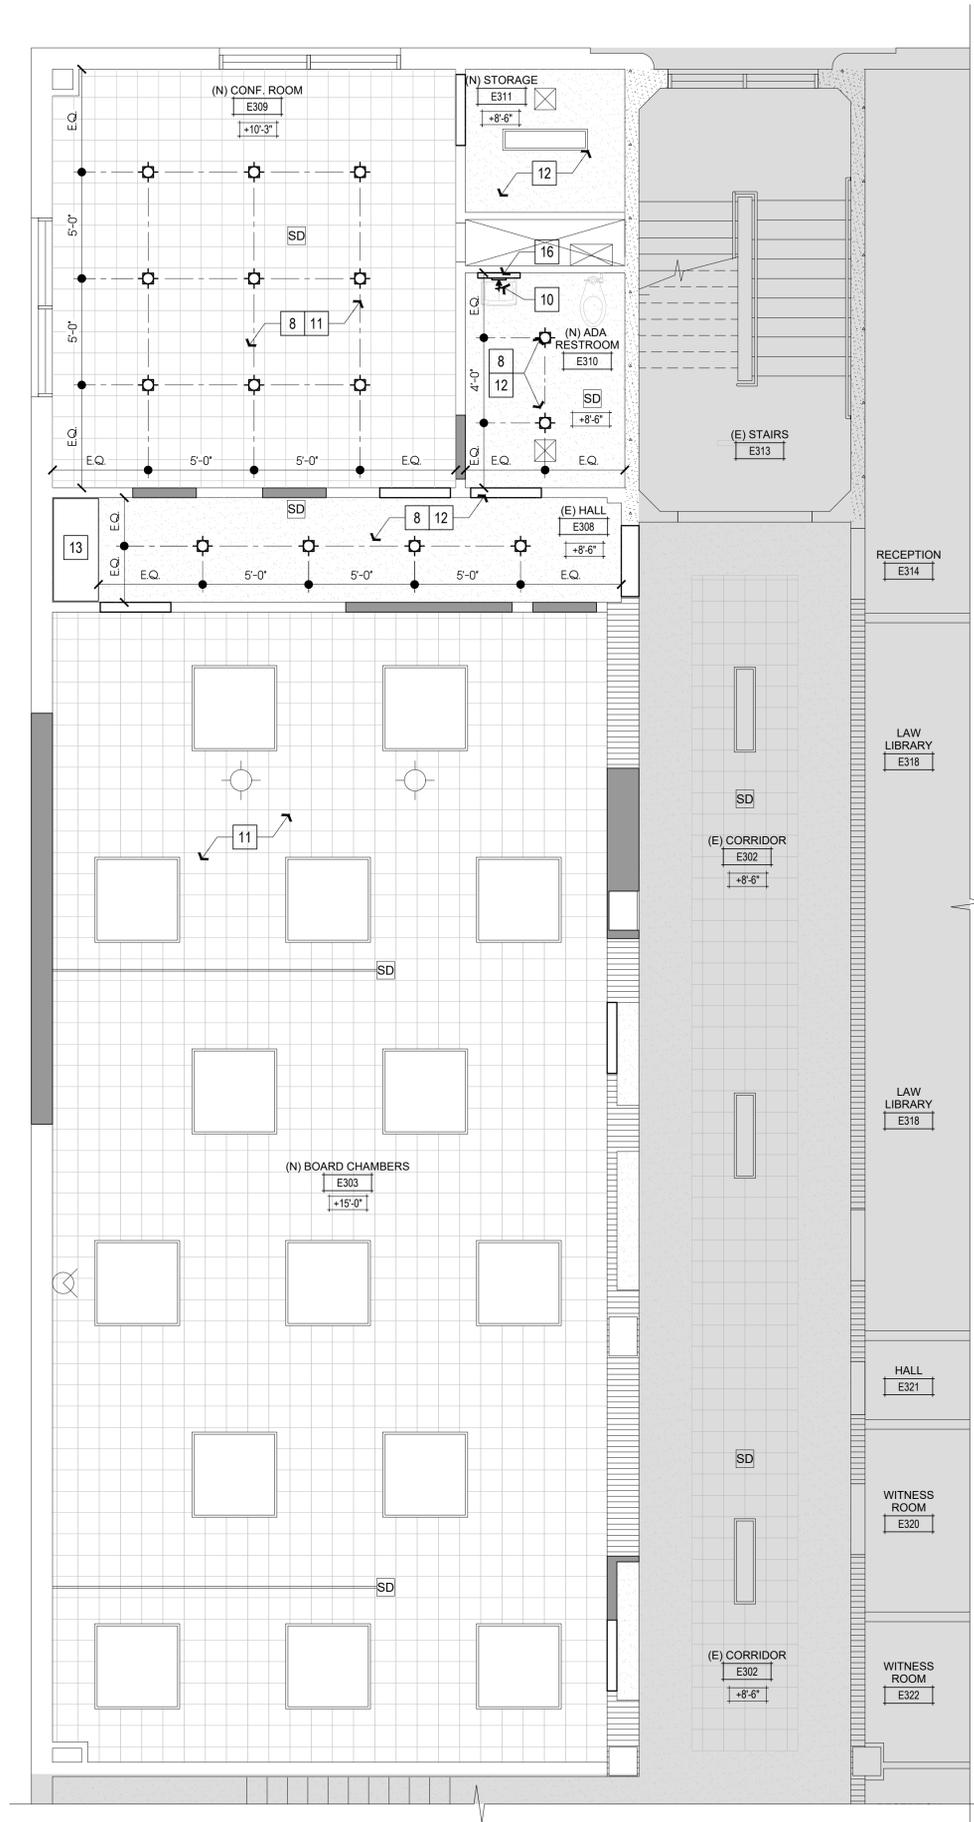

IMPROVEMENT RCP 2
SCALE: 1/4" = 1'-0"

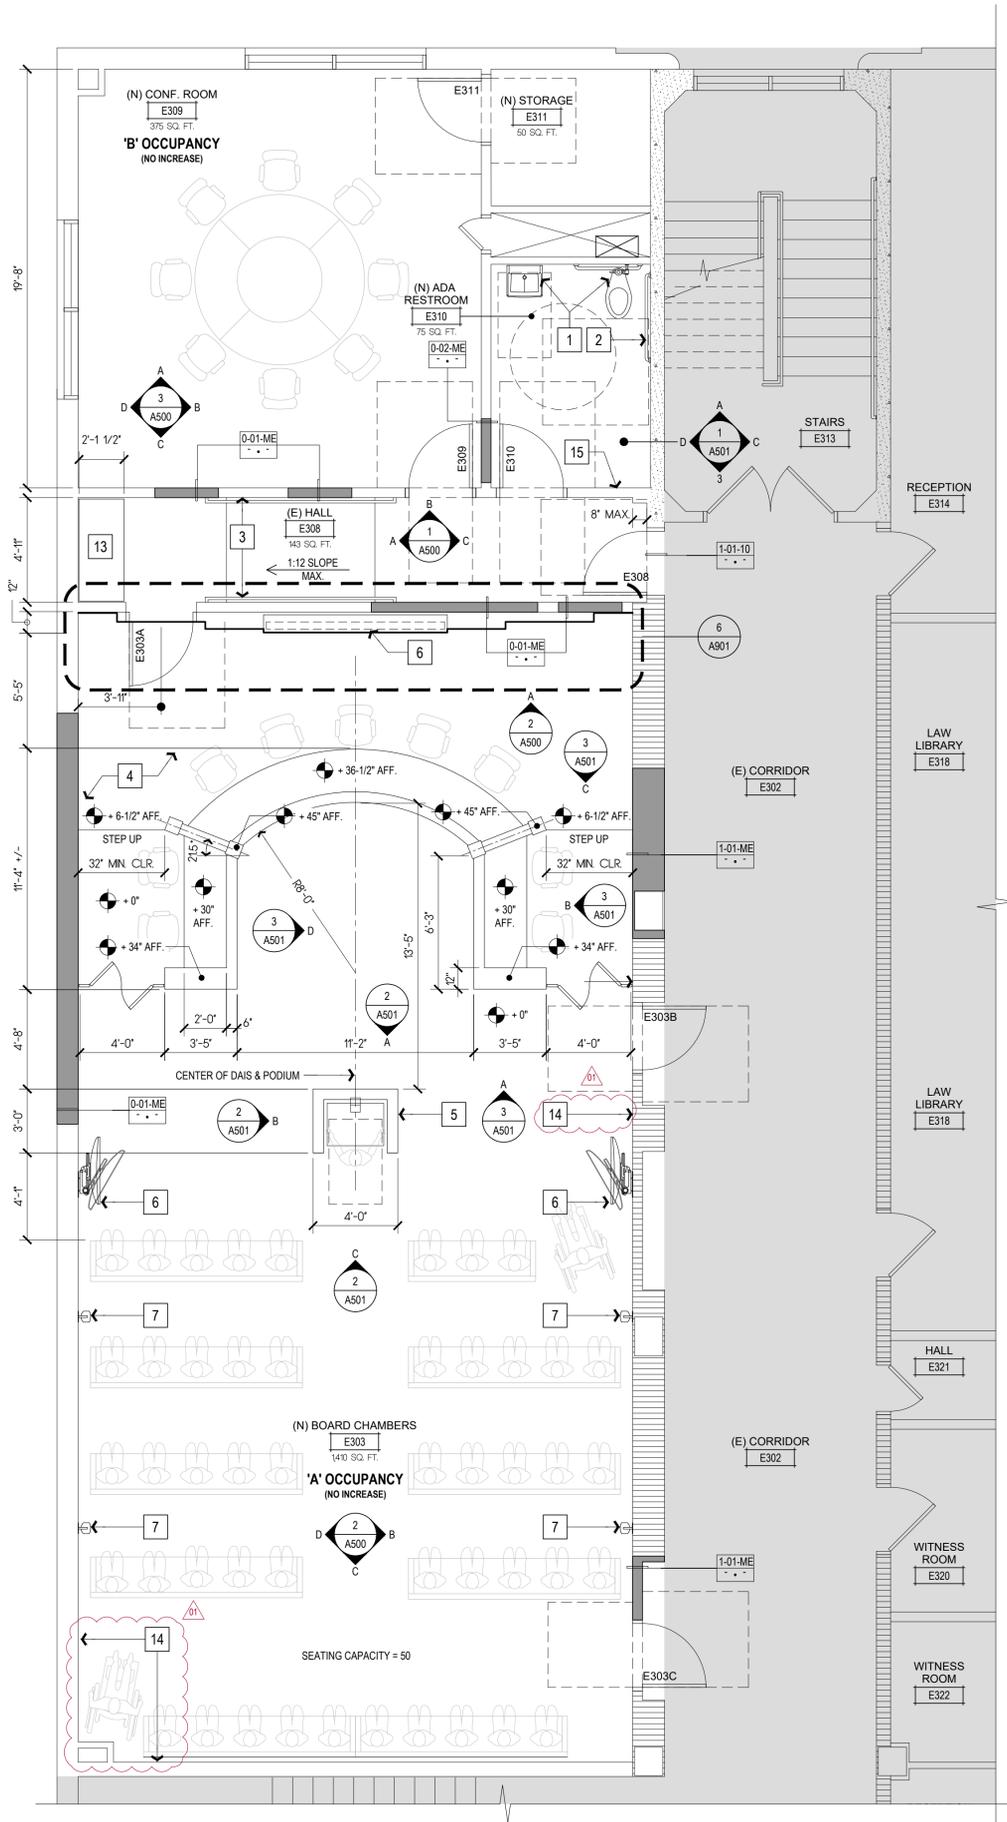

IMPROVEMENT FLOOR PLAN 1
SCALE: 1/4" = 1'-0"

GENERAL NOTES

- REFER TO PLUMBING AND ELECTRICAL DRAWINGS FOR ADDITIONAL INFORMATION AND EQUIPMENT NOT SHOWN ON THIS PLAN.
- SEE DOOR SCHEDULE, SHEET A710, FOR ADDITIONAL INFORMATION AND TYPES. NO HARDWARE SHOWN ON INTERIOR ELEVATIONS.
- ALL FURNITURE TO BE O.F.O.I., UNLESS OTHERWISE NOTED.
- CONTRACTOR TO FIELD VERIFY THAT EXISTING PARTITIONS-TO-REMAIN CONFORM WITH REQUIREMENTS FOR FIRE RESISTANCE AND/OR SMOKE BARRIERS WITHIN THE CONTRACT AREA. SEE COVER SHEET FOR CONTRACT AREA (AREA OF PROPOSED REMODEL).
- EXISTING CONDITIONS: DIMENSIONS AND CONDITIONS TYING INTO, OR GOVERNED BY, EXISTING CONSTRUCTION ARE APPROXIMATE. SUCH DIMENSIONS SHALL BE FIELD VERIFIED BY THE CONTRACTOR PRIOR TO PREPARATION OF SHOP DRAWINGS. THE FIRST SUBMITTAL OF SHOP DRAWINGS SHALL CONTAIN FIELD VERIFIED DIMENSIONS AND CONDITIONS. IF DIMENSIONS OR CONDITIONS SIGNIFICANTLY VARY FROM THOSE INDICATED BY THE CONTRACT DOCUMENTS, THE CONTRACTOR SHALL PROMPTLY NOTIFY THE ARCHITECT BEFORE PREPARATION OF THE SHOP DRAWINGS.
- WHERE TWO DIFFERING SHEET VINYL FLOORINGS (OR OTHER SEAMLESS FLOORING MATERIALS) CREATE A TRANSITION AT A DOORWAY, THEY SHALL BE SEALED AND BUTTED TOGETHER AT THE CENTERLINE OF THE DOOR PER MANUFACTURER'S INSTALLATION INSTRUCTIONS.
- REFER TO SHEET A800 FOR TYPICAL FRAMING DETAILS AND REQUIREMENTS, TYPICAL.

KEYNOTES

- (N) ACCESSIBLE RESTROOM FIXTURES. SEE PLUMBING DRAWINGS FOR MORE INFORMATION
- (N) GRAB BAR, SEE DETAIL 2/A902
- (N) HANDRAIL, SEE DETAILS 3 & 4/A901
- (N) SLEEPER PLATFORM, SEE DETAIL 5/A901
- (N) ACCESSIBLE ELECTRICALLY ADJUSTABLE LECTERN, SEE DETAIL 1/A940
- (N) WALL-MOUNTED TELEVISION, SEE DETAIL 1/A902. WALL LOCATION & ELEVATION SIZE PER OWNER, OFCI
- (N) WALL-MOUNTED SPEAKERS, WALL LOCATION PER OWNER. SEE ELECTRICAL DRAWINGS FOR MORE INFORMATION
- (N) LIGHTING FIXTURES. SEE ELECTRICAL DRAWINGS FOR MORE INFORMATION
- TACTILE SIGN STATING "ASSISTIVE LISTENING SYSTEM AVAILABLE" COMPLYING WITH CBC SECTION 1104B.2.4, SEE DETAIL 3A960
- (N) EXHAUST FAN, SEE MECHANICAL DRAWINGS FOR MORE INFORMATION
- REPLACE (E) ACOUSTICAL CEILING TILES FROM DEMOLITION, MATCH ADJACENT FINISHES
- PATCH AND REPAIR CEILING
- (N) FULL HEIGHT CABINET, SEE DETAIL 4/A902
- (N) GYP. BOARD AT FLOOR BASE, WHERE OCCURS, SEE 10/A902
- (N) HORN AND STROBE WARNING DEVICE AT 84" AFF., TIE INTO (E) FIRE ALARM SYSTEM
- (N) WALL MOUNTED LIGHTING FIXTURE, SEE ELECTRICAL DRAWINGS FOR MORE INFORMATION

LEGEND

- NO WORK IN THIS AREA
- (E) NON-RATED PARTITION TO REMAIN
- (E) 1 HOUR RATED FIRE PARTITION TO REMAIN
- (E) 4'x4' LIGHT FIXTURE TO REMAIN SEE ELECTRICAL DRAWINGS
- (E) 1'x4' LIGHT FIXTURES TO REMAIN SEE ELECTRICAL DRAWINGS
- (E) SMOKE DETECTOR TO REMAIN



NICHOLS MELBURG & ROSSETTO
ARCHITECTS + ENGINEERS
2455 Bennett Valley Rd., Ste. B303
Santa Rosa, CA 95404
(707) 536-2121 (530) 222-3538 Fax
http://www.nmrdesign.com

REVISIONS

Delta	Description	Date
Δ/B	BID SET #2	09/06/2023
Δ/01	ADDENDUM #1	09/27/2023

If drawing is not 24" x 36" it is a reduced print

Copyright © 2023

All ideas, designs, arrangements and plans indicated or represented by this drawing are owned by, and the property of, NICHOLS MELBURG and ROSSETTO and were created, evolved and developed for use on, and in conjunction with, the specified project. None of such ideas, designs, arrangements or plans shall be used by, or disclosed to any person, firm or corporation for any purpose whatsoever without the written permission of NICHOLS MELBURG and ROSSETTO.

AGENCY APPROVAL

LICENSE STAMPS



PROJECT NAME

**B.O.S. CHAMBERS
REMODEL
FOR**



311 FOURTH STREET
YREKA, CALIFORNIA, 96097


SHEET TITLE

**IMPROVEMENT
ENLARGED FLOOR PLAN
& RCP**


DRAWING STATUS
**CONSTRUCTION
DOCUMENTS**

Drawn By	JR
Date Issued	05/18/2023
Scale	1/4" = 1'-0"
Project No.	22-6513


SHEET No.
A220

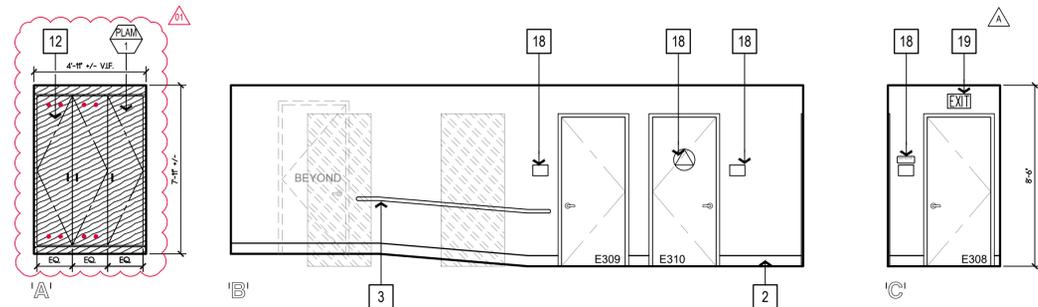


1 E308 HALL
1/4" = 1'-0"

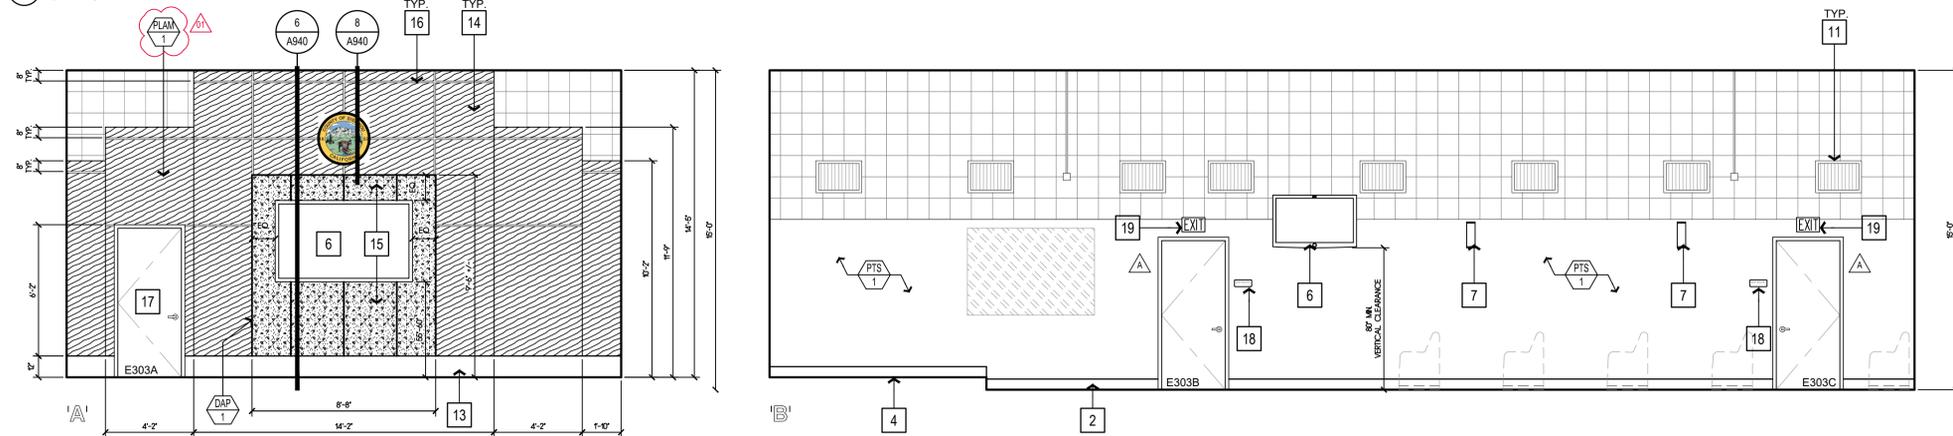

2 E303 BOARD CHAMBERS
1/4" = 1'-0"

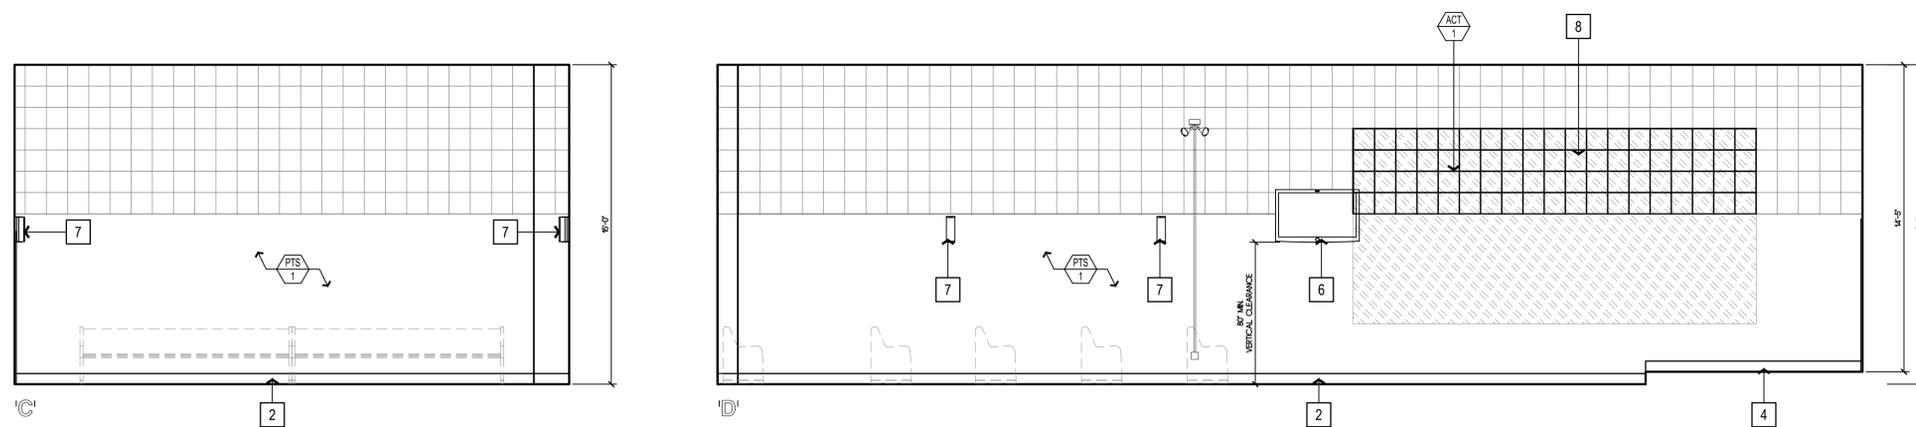

2 E303 BOARD CHAMBERS
1/4" = 1'-0"

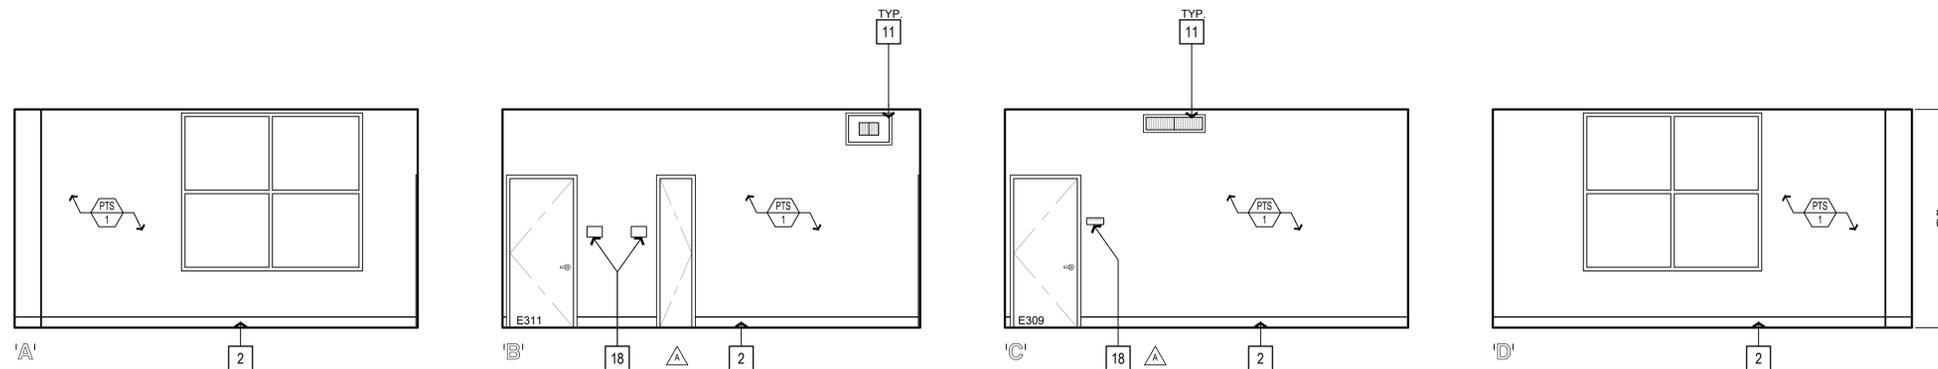

3 E309 CONFERENCE ROOM
1/4" = 1'-0"

GENERAL NOTES

- ALL DIMENSIONS SHOWN ARE FROM FACE OF FINISH OR FINISH FLOOR.
- REMOVE AND REPLACE EXISTING GYPSUM BOARD AS REQUIRED TO INSTALL NEW PLUMBING FIXTURES, ELECTRICAL RECEPTACLES & CONDUITS, AND BACKING FOR NEW EQUIPMENT. MATCH EXISTING TEXTURE.
- SEE SHEET G211 FOR PLUMBING FIXTURE MOUNTING HEIGHTS.
- PAINT ALL INTERIOR SURFACES (WALLS AND CEILINGS) IN AREA OF WORK. SEE FINISH SCHEDULE, SHEET A700, FOR ADDITIONAL INFORMATION.
- SEE DOOR SCHEDULE, SHEET A710, FOR ADDITIONAL DOOR INFORMATION AND TYPES. NO HARDWARE SHOWN ON INTERIOR ELEVATIONS.
- SEE FLOOR PLAN SHEET A220 FOR ADDITIONAL EQUIPMENT INFORMATION.
- SEE PLUMBING AND ELECTRICAL DRAWINGS FOR ADDITIONAL INFORMATION AND EQUIPMENT NOT SHOWN ON INTERIOR ELEVATIONS.

ELEVATION KEYNOTES

- 1 (N) ACCESSIBLE RESTROOM FIXTURES, SEE PLUMBING DRAWINGS FOR MORE INFORMATION
- 2 (N) BASE AT CARPET FLOORING, SEE DETAIL 6/A902
- 3 (N) HANDRAIL, SEE DETAILS 3 & 4A/901
- 4 (N) SLEEPER PLATFORM, SEE DETAIL 5/A901
- 5 (N) ACCESSIBLE ELECTRICALLY ADJUSTABLE LECTERN, SEE DETAIL 1/A940
- 6 (N) WALL-MOUNTED TELEVISION, SEE DETAIL 1/A902 SEE ELECTRICAL DRAWINGS FOR MORE INFORMATION, WALL LOCATION & ELEVATION SIZE PER OWNER, OFCI
- 7 (N) WALL-MOUNTED SPEAKERS, WALL LOCATION PER OWNER SEE ELECTRICAL DRAWINGS FOR MORE INFORMATION.
- 8 (N) NEW ACOUSTICAL WALL TILES, MATCH ADJACENT FINISHES
- 9 (N) TACTILE SIGN STATING "ASSISTIVE LISTENING SYSTEM AVAILABLE" COMPLYING WITH CBC SECTION 1104B.2.4, SEE DETAIL 3A960
- 11 PAINT EXISTING DIFFUSERS, SEE FINISH SCHEDULE
- 12 FULL HEIGHT CABINET, SEE DETAIL 4/A902
- 13 BASE AT WALL PANEL, SEE DETAIL 9/A940
- 14 VENEER PLYWOOD AT CASEWORK
- 15 POLYMER PANELING W/ STANDOFF SYSTEM SUPPORT
- 16 PANEL SHADOW REVEALS
- 17 DOOR, SEE DOOR SCHEDULE
- 18 ADA TACTILE SIGNAGE, SEE SPECIFICATION SECTION 10 14 00
- 19 PHOTOLUMINESCENT EXIT SIGNS ABOVE DOOR

LEGEND

FOR MORE INFORMATION AND FINISH COLOR SELECTIONS, SEE FINISH SCHEDULE, SHEET A700

- PAINTED WALL, TYPICAL
- WALL TILE FINISH
- ACOUSTICAL WALL TILES
- NEW PAINTED GYP. BOARD WALL
- PLASTIC LAMINATE (GRAIN VERTICAL)
- RESIN SURFACE SURROUND
- WALL INFILL DETAIL 6/A900
- FINISH TAG TYPICAL - SEE FINISH SCHEDULE



NICHOLS MELBURG & ROSSETTO
ARCHITECTS + ENGINEERS
2455 Bennett Valley Rd., Ste. B303
Santa Rosa, CA 95404
(707) 536-2121 (530) 222-3538 Fax
http://www.nmrdesign.com

REVISIONS		
Delta	Description	Date
1	BACKCHECK 01	05/22/2023
2	BID SET #2	09/06/2023
3	ADDENDUM #1	09/27/2023

If drawing is not 24" x 36" it is a reduced print

Copyright © 2023
All ideas, designs, arrangements and plans indicated or represented by this drawing are owned by, and the property of, NICHOLS MELBURG and ROSSETTO and were created, evolved and developed for use on, and in conjunction with, the specified project. None of such ideas, designs, arrangements or plans shall be used by, or disclosed to any person, firm or corporation for any purpose whatsoever without the written permission of NICHOLS MELBURG and ROSSETTO.

AGENCY APPROVAL

LICENSE STAMPS



PROJECT NAME

B.O.S. CHAMBERS
REMODEL
FOR



311 FOURTH STREET
YREKA, CALIFORNIA, 96097

SHEET TITLE


INTERIOR ELEVATIONS

DRAWING STATUS
CONSTRUCTION
DOCUMENTS


Drawn By	JR
Date Issued	05/18/2023
Scale	1/4" = 1'-0"
Project No.	22-6513

SHEET No.


A500

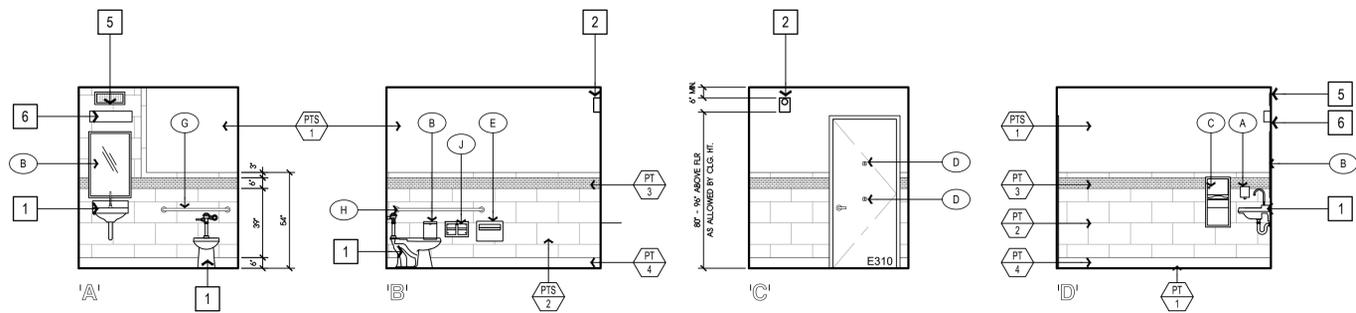

1 E310 ADA GENDER NEUTRAL RESTROOM
1/4" = 1'-0"

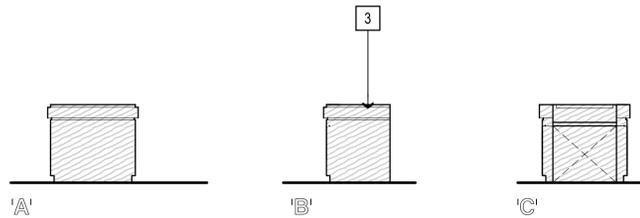

2 E303 BOARD CHAMBERS - LECTERN
1/4" = 1'-0"

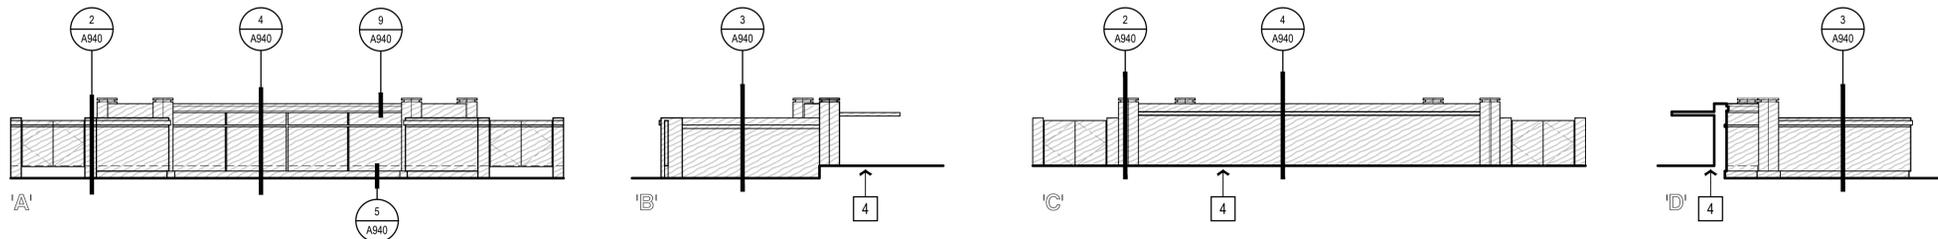


3 E303 BOARD CHAMBERS - DAIS
1/4" = 1'-0"

GENERAL NOTES

- ALL DIMENSIONS SHOWN ARE FROM FACE OF FINISH OR FINISH FLOOR.
- REMOVE AND REPLACE EXISTING GYPSUM BOARD AS REQUIRED TO INSTALL NEW PLUMBING FIXTURES, ELECTRICAL RECEPTACLES & CONDUITS, AND BACKING FOR NEW EQUIPMENT. MATCH EXISTING TEXTURE.
- SEE SHEET G211 FOR PLUMBING FIXTURE MOUNTING HEIGHTS.
- PAINT ALL INTERIOR SURFACES (WALLS AND CEILINGS) IN AREA OF WORK. SEE FINISH SCHEDULE, SHEET A700, FOR ADDITIONAL INFORMATION.
- SEE DOOR SCHEDULE, SHEET A710, FOR ADDITIONAL DOOR INFORMATION AND TYPES. NO HARDWARE SHOWN ON INTERIOR ELEVATIONS.
- SEE FLOOR PLAN SHEET A220 FOR ADDITIONAL EQUIPMENT INFORMATION.
- SEE PLUMBING AND ELECTRICAL DRAWINGS FOR ADDITIONAL INFORMATION AND EQUIPMENT NOT SHOWN ON INTERIOR ELEVATIONS.

ELEVATION KEYNOTES

- 1 (N) ACCESSIBLE RESTROOM FIXTURES, SEE PLUMBING DRAWINGS FOR MORE INFORMATION
- 2 (N) HORN AND STROBE WARNING DEVICE AT 84" AFF., TIE INTO (E) FIRE ALARM SYSTEM
- 3 (N) ACCESSIBLE ELECTRICALLY ADJUSTABLE LECTERN, SEE DETAIL 1/A940
- 4 (N) SLEEPER PLATFORM, SEE DETAIL 5/A901
- 5 (N) EXHAUST FAN, SEE MECHANICAL DRAWINGS FOR MORE INFORMATION
- 6 (N) WALL MOUNTED LIGHTING FIXTURE, SEE ELECTRICAL DRAWINGS FOR MORE INFORMATION

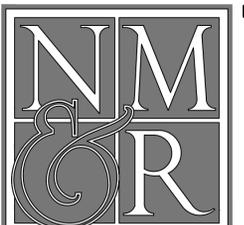

NICHOLS MELBURG & ROSSETTO
ARCHITECTS + ENGINEERS
2455 Bennett Valley Rd., Ste. B303
Santa Rosa, CA 95404
(707) 536-2121 (530) 222-3538 Fax
http://www.nmrdesign.com

REVISIONS

Delta	Description	Date
Δ/8	BID SET #2	09/06/2023
Δ/11	ADDENDUM #1	09/27/2023

If drawing is not 24" x 36" it is a reduced print

Copyright © 2023

All ideas, designs, arrangements and plans indicated or represented by this drawing are owned by, and the property of, NICHOLS MELBURG and ROSSETTO and were created, evolved and developed for use on, and in conjunction with, the specified project. None of such ideas, designs, arrangements or plans shall be used by, or disclosed to any person, firm or corporation for any purpose whatsoever without the written permission of NICHOLS MELBURG and ROSSETTO.

AGENCY APPROVAL

LEGEND

FOR MORE INFORMATION AND FINISH COLOR SELECTIONS, SEE FINISH SCHEDULE, SHEET A700

- PAINTED WALL, TYPICAL
- WALL TILE FINISH
- NEW PAINTED GYP. BOARD WALL
- PLASTIC LAMINATE (GRAIN VERTICAL) Δ/11
- FINISH TAG TYPICAL - SEE FINISH SCHEDULE

LICENSE STAMPS



PROJECT NAME

B.O.S. CHAMBERS
REMODEL
FOR



311 FOURTH STREET
YREKA, CALIFORNIA, 96097

SHEET TITLE

ACCESSORY SCHEDULE

SEE SHEET G211, FOR ACCESSORY MOUNTING HEIGHTS AND REQUIRED CLEARANCES.

- A SURFACE MOUNTED SOAP DISPENSER
- B SURFACE MOUNTED MIRROR - 24"W x 36"H
- C RECESSED PAPER TOWEL DISPENSER AND WASTE RECEPTACLE
- D SURFACE MOUNTED COAT HOOK
- E RECESSED TOILET SEAT COVER DISPENSER
- F RECESSED SANITARY NAPKIN DISPOSAL
- G SURFACE MOUNTED GRAB BAR - 36" (36" MIN. AT ACCESSIBLE WATER CLOSET)
- H SURFACE MOUNTED GRAB BAR - 48" (42" MIN. AT ACCESSIBLE WATER CLOSET)
- J RECESSED TOILET TISSUE DISPENSER

INTERIOR ELEVATIONS


DRAWING STATUS

CONSTRUCTION
DOCUMENTS

Drawn By	JR
Date Issued	05/18/2023
Scale	1/4" = 1'-0"
Project No.	22-6513

SHEET No.


A501

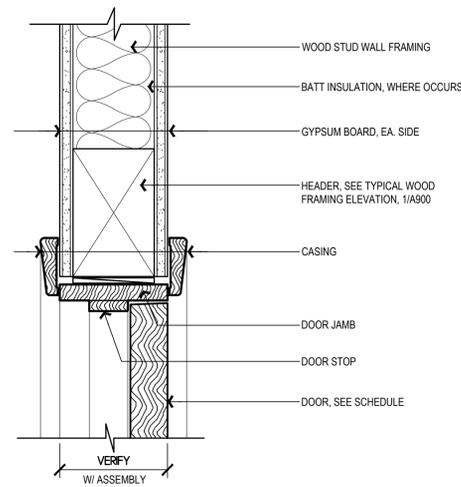

WOOD DOOR HEADER

SCALE: 3" = 1'-0"


1

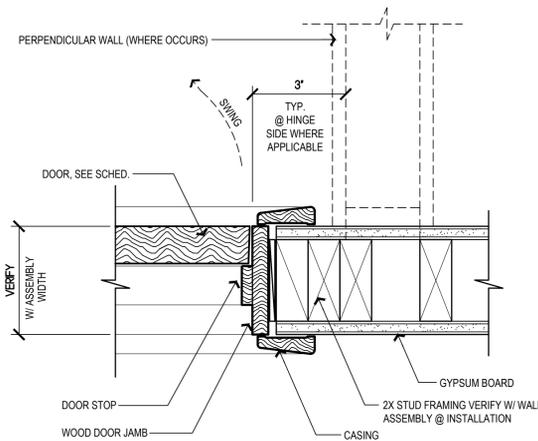

WOOD DOOR JAMB - HINGE SIDE

SCALE: 3" = 1'-0"

2

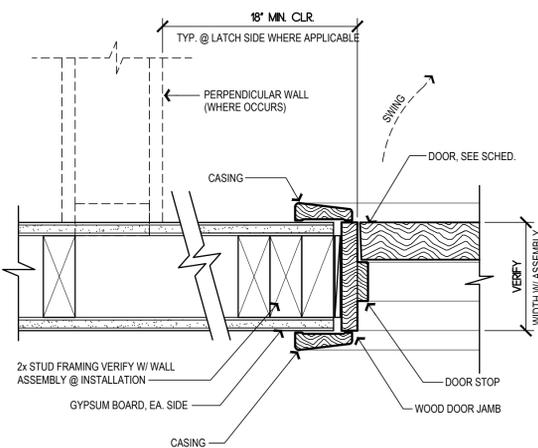

WOOD DOOR JAMB - LATCH SIDE

SCALE: 3" = 1'-0"

3

DOOR SCHEDULE

DOOR NUMBER	DOOR				FRAME			DETAILS			FIRE RATING	HARDWARE GROUP	DOOR REMARKS	
	SIZE	TYPE	MATERIAL	FINISH	TYPE	MATERIAL	FINISH	DOOR BUMPER	HEAD	JAMB				THRESHOLD
E303A	3'-0" x 7'-0"	S1	WD	FF	A	-	PT	-	1/A710	2 & 3/A710	7/A710	NR	1.0	1, 4
E303B	3'-0" x 7'-0"	S1	WD	FF	A	-	PT	-	1/A710	2 & 3/A710	9/A710	20 MIN.	2.0	1, 4
E303C	3'-0" x 7'-0"	S1	WD	FF	A	-	PT	-	1/A710	2 & 3/A710	9/A710	20 MIN.	2.0	1, 4
E308	3'-0" x 7'-0"	S1	WD	FF	A	-	PT	-	1/A710	2 & 3/A710	9/A710	20 MIN.	3.0	1, 3, 4
E309	3'-0" x 7'-0"	S1	WD	FF	A	-	PT	-	1/A710	2 & 3/A710	7/A710	NR	4.0	1, 4
E310	3'-0" x 7'-0"	S1	WD	FF	A	-	PT	-	1/A710	2 & 3/A710	8/A710	NR	5.0	1, 2, 4
E311	3'-0" x 7'-0"	S1	WD	FF	A	-	PT	-	1/A710	2 & 3/A710	9/A710	NR	6.0	-

DOOR HARDWARE

HARDWARE SET: 1.0, DOORS: 303A

QTY./ITEM	MODEL #	FINISH	MFR.
3 HINGE	TA2714 - 4 1/2" X 4 1/2"	US26D	MK
1 PASSAGE LOCKSET	ND10S	US26D	SCH
1 CYLINDRICAL LOCK	...	26D	SCH
1 SURFACE CLOSER	4041 CUSH	AL	LCN
1 KICK PLATE	K1050 10" X 34"	US32D	RO
1 GASKETING	S44BL WIDTH X HEIGHT	...	PE
1 DOOR SHOE	XG2212APK773BL	...	PE
1 THRESHOLD	1716A	...	PE

HARDWARE SET: 3.0, DOORS: E308

QTY./ITEM	MODEL #	FINISH	MFR.
3 HINGE	TA2714 - 4 1/2" X 4 1/2"	US26D	MK
1 ELECTRIC STRIKE	1600CS	629	HES
1 SURFACE CLOSER	4041 CUSH	AL	LCN
1 KICK PLATE	K1050 10" X 34"	US32D	RO
1 WALL STOP	406/409	US26D	RO
1 GASKETING	S44BL WIDTH X HEIGHT	...	PE
1 DOOR SHOE	XG2212APK773BL	...	PE
1 THRESHOLD	1716A	...	PE
1 DEADBOLT	B560626	626	SCH
1 CARD READER

HARDWARE SET: 5.0, DOORS: E310

QTY./ITEM	MODEL #	FINISH	MFR.
3 HINGE	TA2714 - 4 1/2" X 4 1/2"	US26D	MK
1 PASSAGE LOCKSET	ND10S	626	SCH
1 DEADBOLT W/ INDICATOR	B571626	US26D	SCH
1 SURFACE CLOSER	4041 CUSH	AL	LCN
1 KICK PLATE	K1050 10" X 34"	US32D	RO
1 MOP PLATE	K1050 6" X 34"	US32D	RO
1 WALL STOP	406/409	US26D	RO
1 GASKETING	S44BL WIDTH X HEIGHT	...	PE

HARDWARE SET: 2.0, DOORS: 303B, 303C

QTY./ITEM	MODEL #	FINISH	MFR.
3 HINGE	TA2714 - 4 1/2" X 4 1/2"	US26D	MK
1 CLASSROOM LOCKSET	ND70PD	US26D	SCH
1 CYLINDRICAL LOCK	...	26D	SCH
1 SURFACE CLOSER	4041 CUSH	AL	LCN
1 KICK PLATE	K1050 10" X 34"	US32D	RO
1 GASKETING	S44BL WIDTH X HEIGHT	...	PE
1 DOOR SHOE	XG2212APK773BL	...	PE
1 THRESHOLD	1716A	...	PE


HARDWARE SET: 4.0, DOORS: E309

QTY./ITEM	MODEL #	FINISH	MFR.
3 HINGE	TA2714 - 4 1/2" X 4 1/2"	US26D	MK
1 PASSAGE LOCKSET	ND10S	626	SCH
1 CYLINDRICAL LOCK	...	26D	SCH
1 SURFACE CLOSER	4041 CUSH	AL	LCN
1 KICK PLATE	K1050 10" X 34"	US32D	RO
1 WALL STOP	406/409	US26D	RO
1 GASKETING	S44BL WIDTH X HEIGHT	...	PE


HARDWARE SET: 6.0, DOORS: E311

QTY./ITEM	MODEL #	FINISH	MFR.
3 HINGE	TA2714 - 4 1/2" X 4 1/2"	US26D	MK
1 STORE ROOM LOCKSET	ND96PD	626	SCH
1 CYLINDRICAL LOCK	...	26D	SCH
1 WALL STOP	406/409	US26D	RO


DOOR FRAME

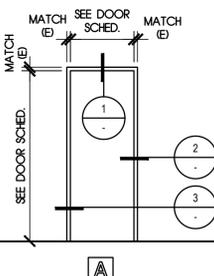

DOOR TYPE

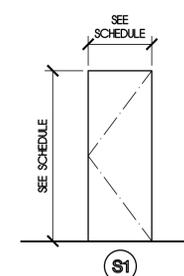


DOOR MOUNTING HEIGHTS

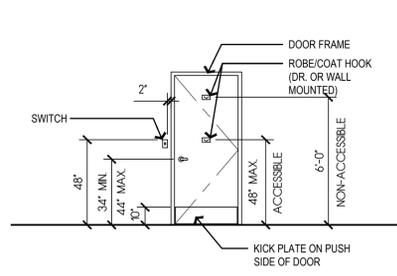

MANUFACTURER'S ABBR.

- 1. BE BESAM
- 2. HS HGS
- 3. I IVES
- 4. LCN LCN
- 5. MK MCKINNEY
- 6. NO NORTON
- 7. OT OTHER
- 8. PE PEMCO
- 9. RIX RIXSON
- 10. RO ROCKWOOD
- 11. SA SARGENT
- 12. SCH SCHLAGE
- 13. SU SECURITRON
- 14. Z ZERO INTERNATIONAL
- 15. HES HES
- 16. BEA BEA

ACCESSIBLE CLEARANCE AT DOOR

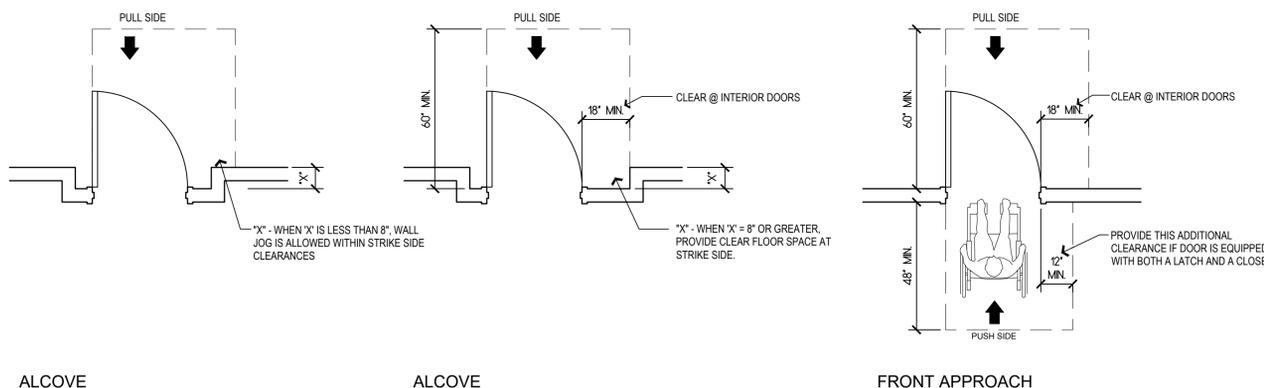

ALCOVE

ALCOVE

FRONT APPROACH

DOOR REMARKS

SEE "DOOR REMARKS" COLUMN AT DOOR SCHEDULE FOR SPECIFIC DOORS TO WHICH THE FOLLOWING NOTES APPLY, TYPICAL.


- DOOR SHALL HAVE SELF-CLOSING DEVICE - SEE HARDWARE GROUPS FOR ADDITIONAL INFORMATION. DOOR SHOULD BE ALLOWED TO CLOSE FULLY AND LATCH, WHILE MEETING ADA REQUIREMENTS.
- DOOR SHALL HAVE ADA & CBC ACCESSIBLE RESTROOM SIGNAGE - SEE INTERIOR ELEVATIONS, SHEET SERIES A500, AND SIGNAGE PLANS, SHEET SERIES A960.
- DOOR LOCK TO BE ACCESSED BY PRESENTING CREDENTIALS AT CARD READER.
- KICK PLATE ON PUSH SIDE OF DOOR TYP.

GENERAL DOOR NOTES

- CONTRACTOR SHALL VERIFY ALL ROUGH OPENINGS PRIOR TO FABRICATION AND DELIVERY OF DOORS AND FRAMES.
- ALL EXITS SHALL BE OPENABLE FROM THE INSIDE WITHOUT THE USE OF ANY SPECIAL KNOWLEDGE OR EFFORT AND WITHOUT REQUIRING THE ABILITY TO GRASP HARDWARE (E.G. PANIC HARDWARE).
- SEE MECHANICAL DRAWINGS FOR MINIMUM IN-DOOR LOUVER SIZES, WHERE OCCURS.
- HAND-ACTIVATED DOOR OPENING HARDWARE, HANDLES, PULLS, LATCHES, LOCKS, AND OTHER OPERATING DEVICES ON ACCESSIBLE DOORS SHALL HAVE A SHAPE THAT IS EASY TO GRASP WITH ONE HAND AND DOES NOT REQUIRE TIGHT GRASPING, TIGHT PINCHING OR TWISTING OF THE WRIST TO OPERATE.
- HARDWARE SHALL BE CENTERED BETWEEN 34 INCHES AND 44 INCHES ABOVE THE FLOOR.
- LATCHING AND LOCKING DOORS THAT ARE HAND-ACTIVATED AND WHICH ARE IN A PATH OF TRAVEL SHALL BE OPERABLE WITH A SINGLE EFFORT BY LEVER-TYPE HARDWARE, PANIC BARS, PUSH-PULL ACTIVATING BARS OR OTHER HARDWARE DESIGNED TO PROVIDE PASSAGE. LOCKED EXIT DOORS SHALL OPERATE AS ABOVE IN EGRESS DIRECTION.
- CONTRACTOR SHALL MAKE ALL DOOR ADJUSTMENTS NECESSARY TO ACCOMMODATE SCHEDULED FLOORING MATERIAL AND PROVIDE LEVEL TRANSITION BETWEEN FLOORING.
- ALL DOORS TO COMPLY WITH C.B.C. 2022 SECTION 1010.
- SEE SHEETS A710 FOR DOOR DETAILS.
- COORDINATE ALL WORK BETWEEN HARDWARE SUPPLIER, SECURITY CONTRACTOR, LOW VOLTAGE CONTRACTOR AND ELECTRICAL CONTRACTOR AS REQUIRED FOR DOORS NEEDING ELECTRICAL OR LOW VOLTAGE FEATURES.
- ALL GLAZING IN DOORS SHALL BE TEMPERED; CLASS 1. VISION PANEL FRAME TO BE THE SAME FINISH AS DOOR FRAME/CASING.
- DOOR OPENING LOCATIONS:
 - ADJACENT (3" TO FLANKING WALL)
 - AT CENTERLINE OF THE ROOM
 - AS DIMENSIONED ON PLAN
- SEE SHEET A960 FOR MOUNTING HEIGHTS OF SIGNAGE.
- FINISH FLOOR TRANSITIONS OCCUR AT CENTERLINE OF DOORS IN THE CLOSED POSITION, U.O.N.
- EFFORT TO OPEN DOORS NOT TO EXCEED 5 POUNDS FOR EXTERIOR DOORS AND 5 POUNDS FOR INTERIOR DOORS (15 POUNDS MAXIMUM IF RATED FIRE DOOR) PER CBC 2022 SECTION 1010.1.3.
- PAINT ALL EXISTING DOORS AND DOOR FRAMES TO REMAIN.
- SEE FINISH SCHEDULE (SHEET A700) FOR ALL COLOR SELECTIONS.

ABBREVIATIONS

- AL ALUMINUM OR ALUMINUM STOREFRONT
- CL CLEAR ANODIZED
- (E) EXISTING
- F.A. FINISH FLOOR
- FF FACTORY FINISH
- GL GLASS/GLAZING
- HM HOLLOW METAL
- MTL METAL
- NA NOT APPLICABLE
- PLAM PLASTIC LAMINATE
- PRM PER MANUFACTURER'S RECOMMENDATIONS
- PT FIELD PAINT WITH SEMI-GLOSS FINISH
- SF STOREFRONT WINDOW
- SS STAINLESS STEEL
- ST CLEAR LACQUER FINISH
- STL STEEL
- (T1) SAFETY GLAZING - CATEGORY I
- (T2) SAFETY GLAZING - CATEGORY II
- V.I.F. VERIFY IN FIELD
- WD SOLID CORE WOOD

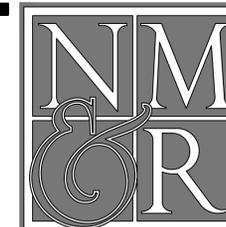

NICHOLS MELBURG & ROSSETTO
ARCHITECTS + ENGINEERS
2455 Bennett Valley Rd., Ste. B303
Santa Rosa, CA 95404
(707) 536-2121 (530) 222-3538 Fax
http://www.nmrdesign.com

REVISIONS

Delta	Description	Date
1	BACKCHECK 01	05/22/2023
2	BID SET #2	09/06/2023
3	ADDENDUM #1	09/27/2023

If drawing is not 24" x 36" it is a reduced print

Copyright © 2023

All ideas, designs, arrangements and plans indicated or represented by this drawing are owned by, and the property of, NICHOLS MELBURG and ROSSETTO and were created, evolved and developed for use on, and in conjunction with, the specified project. None of such ideas, designs, arrangements or plans shall be used by, or disclosed to any person, firm or corporation for any purpose whatsoever without the written permission of NICHOLS MELBURG and ROSSETTO.

AGENCY APPROVAL

LICENSE STAMPS



PROJECT NAME

B.O.S. CHAMBERS
REMODEL
FOR



311 FOURTH STREET
YREKA, CALIFORNIA, 96097

SHEET TITLE


DOOR SCHEDULE
& DETAILS

DRAWING STATUS
CONSTRUCTION
DOCUMENTS


Drawn By	JR
Date Issued	05/18/2023
Scale	AS NOTED
Project No.	22-6513

SHEET No.


A710

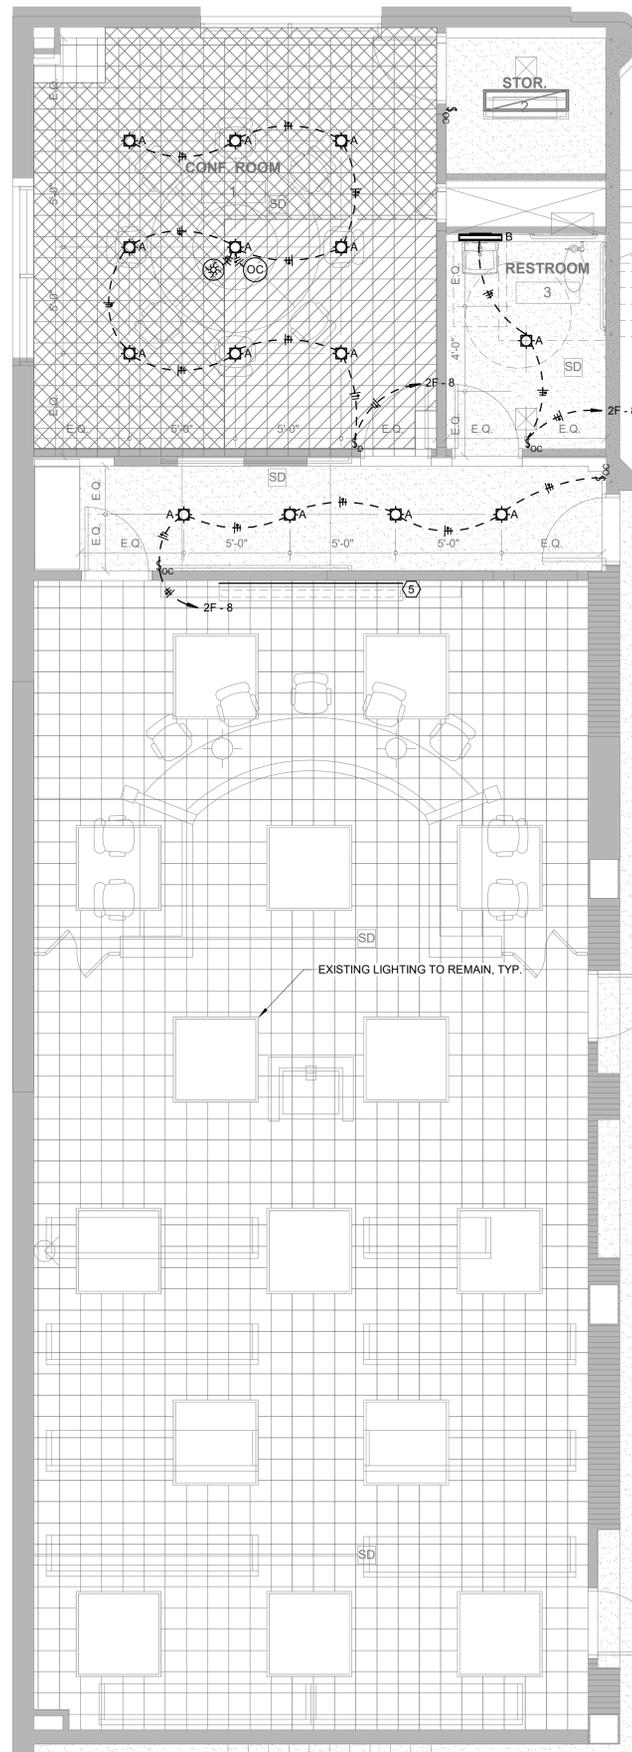

3 ELECTRICAL LIGHTING PLAN
E2.0 1/4" = 1'-0"

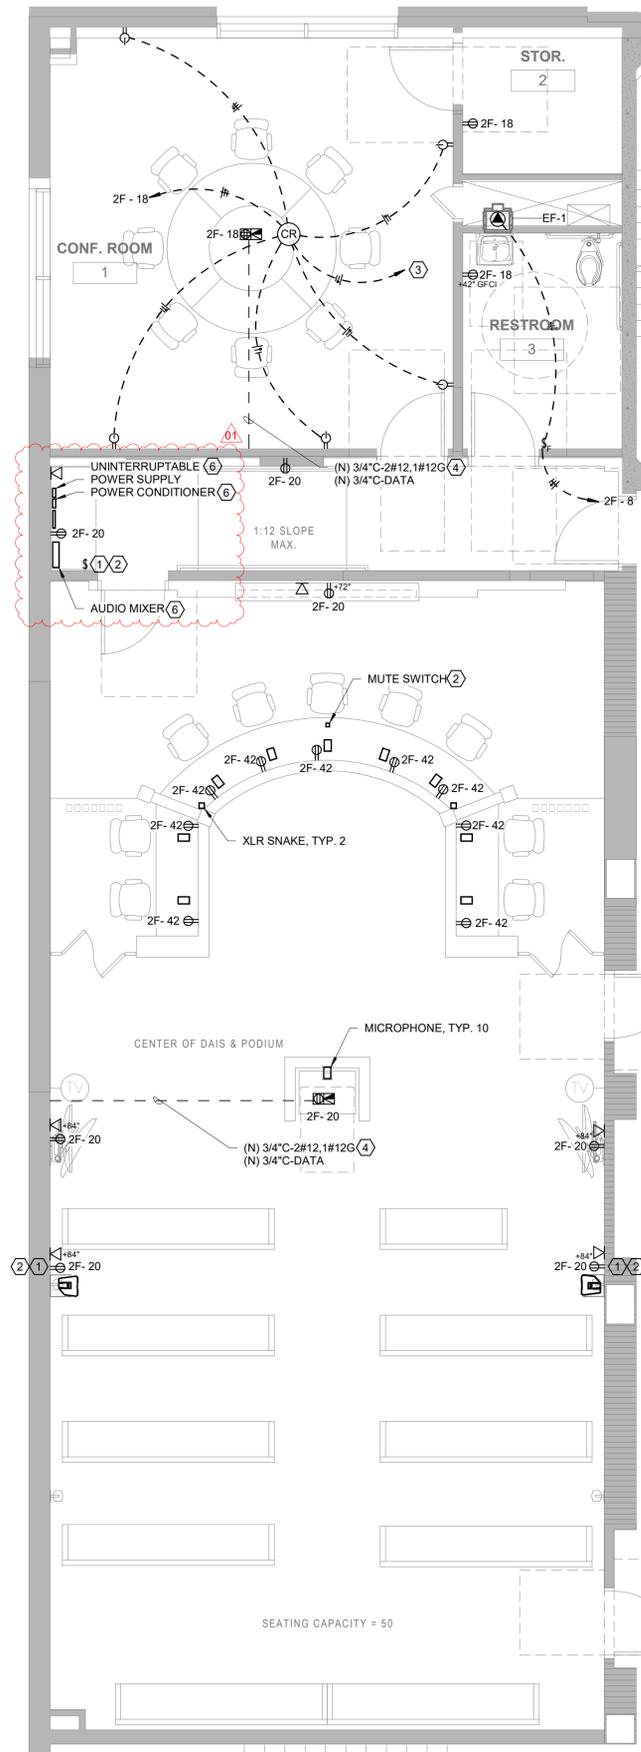

1 ELECTRICAL FLOOR PLAN
E2.0 1/4" = 1'-0"

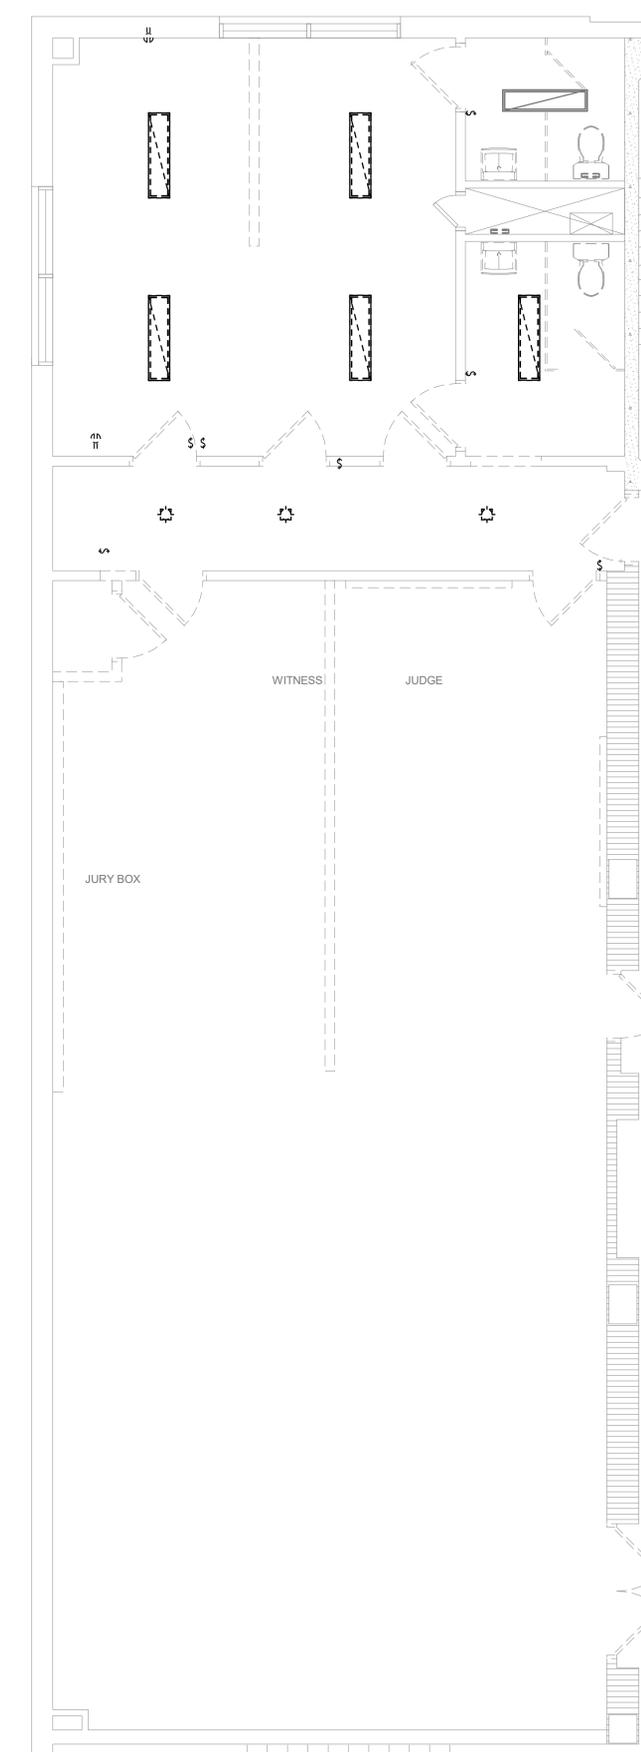

2 ELECTRICAL DEMOLITION PLAN
E2.0 1/4" = 1'-0"

DAYLIGHTING ZONE LEGEND

	PRIMARY DAYLIGHTING ZONE
	SECONDARY DAYLIGHTING ZONE

- GENERAL NOTES**
- RECEPTACLES FOR POWER AND DATA SHALL BE 15" MINIMUM TO THE BOTTOM OF THE BOX AND A MAXIMUM 48" TO THE TOP OF THE BOX ABOVE THE FINISHED FLOOR SURFACE UNLESS OTHERWISE NOTED.
 - LIGHT SWITCHES, THERMOSTATS, AND OTHER SIMILAR ELECTRICAL DEVICES SHALL BE 48" MAXIMUM TO THE TOP OF THE BOX ABOVE FINISHED SURFACE UNLESS OTHERWISE NOTED.
- KEYED NOTES**
- RECEPTACLES FOR ACTIVE SPEAKERS SHALL BE CONTROLLED VIA TOGGLE SWITCH LOCATED IN THE SOUND BOOTH.
 - COORDINATE FINAL LOCATION WITH COUNTY.
 - CONNECT CONTACT RELAY TO LOCAL OCCUPANCY SENSOR FOR SPLITWIRED RECEPTACLE CONTROL.
 - NEW CONDUITS TO BE INSTALLED IN FLOOR. PROVIDE SAW CUTTING AS REQUIRED.
 - PROVIDE LOW VOLTAGE RGB LED STRIP BACKLIGHTING ABOVE NEW WOOD PANELING. COORDINATE FINAL LOCATION WITH ARCHITECT.
 - UNINTERRUPTIBLE POWER SUPPLY, POWER CONDITIONER, AND AUDIO MIXER TO BE LOCATED WITHIN POWER CLOSET.

NICHOLS MELBURG & ROSSETTO
ARCHITECTS + ENGINEERS
2455 Bennett Valley Rd., Ste. B303
Santa Rosa, CA 95404
(707) 536-2121 (530) 222-3538 Fax
<http://www.nmrdesign.com>

REVISIONS

Delta	Description	Date
Δ	BACKCHECK 01	5/22/2023
Δ1	ADDENDUM #1	09/27/2023

If drawing is not 24" x 36" it is a reduced print
Copyright © 2023
All ideas, designs, arrangements and plans indicated or represented by this drawing are owned by, and the property of, NICHOLS MELBURG & ROSSETTO and were created, evolved and developed for use on, and in conjunction with, the specified project. None of such ideas, designs, arrangements or plans shall be used by, or disclosed to any person, firm or corporation for any purpose whatsoever without the written permission of NICHOLS MELBURG & ROSSETTO.

AGENCY APPROVAL

FRONTIER
CONSULTING ENGINEERS
2727 Becheville Lane - Redding, CA 96002
Ph: (530) 232-6160 - www.frontierce.com

LICENSE STAMPS

PROJECT NAME
B.O.S. CHAMBERS
IMPROVEMENT
FOR
COUNTY OF SISKIYOU
CALIFORNIA

311 FOURTH STREET
YREKA, CALIFORNIA, 96097

SHEET TITLE
ELECTRICAL FLOOR
PLANS

DRAWING STATUS
CONSTRUCTION
DOCUMENTS

Drawn By	NW
Date Issued	04/28/2023
Scale	As indicated
Project No.	22-6513

SHEET No.
E2.0



SISKIYOU COUNTY BOARD OF SUPERVISORS CHAMBERS REMODEL

PROJECT #22-6513

9/26/2023



RFI NO.	REC'D.	DWG. REF	DESCRIPTION	Contractor	RESPONSE	SENT TO CONTR.
	09/13/23	Sec. 08 11 00	Confirm Section 08 11 00 - Metal Doors and Frames, is NOT used on this project. I do not see any these on the plans. Provide clarification	Builders Door & Windor, Inc.	Metal doors and frames are not used. Wood frames to match existing.	
	09/13/23	A710	There is no frame type elevation A, it is missing from plan sheet A710. Please provide	Builders Door & Windor, Inc.	Provided door frame elevation, see sheet A710	
	09/25/23		Is there an Engineers Estimate?	Builder Solutions	No Engineers Estimate. Budget of \$300,000.00 to be used	
	09/25/23		Is a Bid Bond on a letter head from our Surety Agency acceptable or is there a Bid Bond Template that the bidders should be using?	Builder Solutions	See Spec section 00 61 13.13	
	09/25/23	Sec 06 41 00 1.5 B	Please verify that white melamine is permitted at semi-exposed surfaces	S+B James Construction	Permitted.	
	09/25/23	A902	Please verify that the Lexan lites (4/A902) are the DAP-1 panels	S+B James Construction	Doors to be PLAM, see revised detail 4/A902.	
	09/25/23	A500	Re: the tall cabinet on 1/A500: a: The elevation shows this as plam doors but the section shows this as a 5-piece with panel. Please verify that this should be palm with no panel.	S+B James Construction	Doors to be PLAM, see revised detail 4/A902.	
	09/25/23	A500	b. The elevation scales this cabinet as 64" wide. Cabinet doors over 24" are not WI compliant. Please verify that I can break this into 2 cabinets (a 1-door and a 2-door cabinet).	S+B James Construction	Permitted, see revised elevation 1A/A500	
	09/25/23	A500	c. Please verify that the "soffit" will be the same plam as the cabinet (not wood veneer).	S+B James Construction	Soffit to be same as cabinet, see revised detail 4/A902.	
	09/25/23	A500	Re: the wall at 2A/A500, the elevation says the bulk of the wall panels are LAM-1 and the sections say it's hardwood paneling. Please verify that the wall panels are PLAM-1.	S+B James Construction	PLAM to be used, see revised sheet A940.	
	09/25/23	A940	The reveal is not detailed in the sections. Please verify that all reveals will just be black.	S+B James Construction	All reveals to be Black PLAM, similar to details 3&4/A940	
	09/25/23	Sec. 12 32 00	In reviewing the specification for the Electrically Operable Lectern, I searched the manufacturers "Chief Professional Mounting Systems", and "Inca Corporation". Both of these came up as manufacturers of television mounting systems and not lecterns. Are there additional approved lectern manufacturers beside Marshall Furniture?	S+B James Construction	See Cut sheet from Marshall Furniture.	
	09/25/23	A220	Keynote 6 on A220 states televisions are owner furnished, contractor installed. Is the same true for the television mounting systems?	S+B James Construction	Owner's subcontractor to provide mounting system, see reference sheet TA0.1.	
	09/25/23	A710	Details 1 through 3 on A710 indicate the door frames are wood. The only specification included for door frames is for hollow metal. Please clarify the type of door frames to be used.	S+B James Construction	Wood door frames.	
	09/25/23	A710	The Door Schedule on A710 calls for solid core wood doors. The specifications include hollow metal doors and PLAM faced wood doors. Please confirm all doors scheduled to be S1 and WD are to be PLAM faced wood doors.	S+B James Construction	Solid core wood doors.	
	09/25/23	E2.0	On E2.0, in Hall E308, the uninterruptible power supply, power conditioner, duplex outlet, audio mixer, and wall switch all conflict with the full height cabinet in this location shown on A220. Please provide revised layout or confirm these are to be mounted in the full height cabinet.	S+B James Construction	Revised, see sheet E2.0.	



SISKIYOU COUNTY BOARD OF SUPERVISORS CHAMBERS REMODEL

PROJECT #22-6513


9/26/2023



RFI NO.	REC'D.	DWG. REF	DESCRIPTION	Contractor	RESPONSE	SENT TO CONTR.
	09/26/23	G002	G002/notes 9, 10, 11a, 11b all speak to rated wall assemblies, but appear to be generic notes. Please confirm that this project will not consist of installing any new fire/smoke dampers in the existing mechanical system. We are aware of the existing diffusers in the rated corridor wall, but are unable to determine if they are currently rated with smoke/fire dampers ect...	S+B James Construction	No new fire/somke dampers in scope of work. Existing to Remain.	
	09/26/23	MP2.0	2/MP2.0 shows a new 6" diameter duct from the new exhaust fan extending up to the roof. Please confirm if this is to penetrate through the roof, or terminate into the existing shaft/attic space. If it is to penetrate through the roof, please provide roof assembly detail including type of construction/layers above exposed sheathing as seen from below.	S+B James Construction	New penetration detail provided, see 11/A902	
	09/26/23	A901	Note 4/A200 calls for a new sleeper platform to be built. The elevation of the platform is shown on the floor plan as 6.5" AFF. Note 4/A200 refers to detail 5/A901, which shows the construction of the platform. If built per this detail the subfloor elevation of the platform would be 8.5" AFF, exceeding code for the riser height. Please clarify these conditions. (2x4 sleepers @ 1.5", 2x6 floor joists @ 5.5", 2 layers of 3/4" sheathing @ 1.5" equals 8.5" tall)	S+B James Construction	Revised 2x6 floor joist to 2x4, see detail 5/A901.	
	09/26/23	BP	Please confirm who is paying for the building permit.	S+B James Construction	Contractor to include \$2,500.00 allowance for Building Permit, see Siskiyou County BD	
	09/27/23	Sec. 23 05 93	The HVAC spec includes TAB. There is one piece of equipment to be installed, an exhaust fan which has the grill mounted directly to it. Other than setting the speed and recording it, please confirm no other TAB is required.	S+B James Construction	Confirmed, Toilet Room to be Negative to Hall.	
	09/27/23	A100	Room E311 has existing tile wainscot and flooring. A safe assumption is these are to be removed, however, and you please confirm these are to be removed in their entirety?	S+B James Construction	Remove in its entirety, see Demolition Keynotes 7 & 8/A100	
	09/14/23	TA0.1	They quoted 6 speakers plans show 4. So we just need to know if they will need to order the other 2. TBD by county, clarify via addendum if 6 would be preferred, include the additional towards the last row of seating.		Low Voltage Scope – Contractor to provide all conduit, boxes, etc. for low voltage scope. Cabling and wall mounted accessories by Others. See reference drawing TA0.1	
	09/14/23	E2.0	Data added to the power closet clarify on electrical, doesn't appear to show on plan.		Data added, see E2.0	
	09/14/23	A220 & A500	Acoustical Ceiling and Wall Tile Repair		Contractor to include 4 cases of tile for ceiling at E303 and 8 cases for wall at E303 and ceiling at E309. Material remaining to be returned to Owner at Project Completion.	

9/25/2023 2:43:30 PM, S.Anderson

RISER DIAGRAM

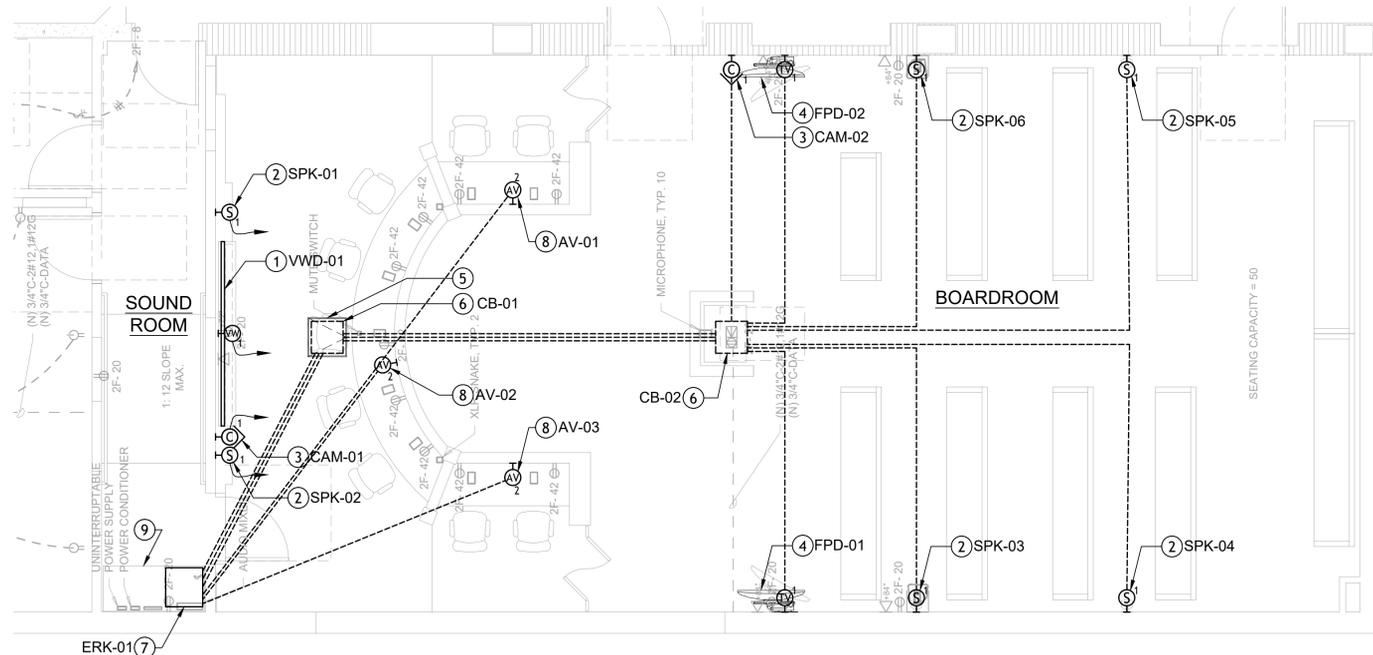

1 BOARDROOM & SOUND ROOM FLOOR PLAN DIAGRAM
SCALE: 1/4" = 1'-0" NORTH

FLOOR PLAN DIAGRAM KEYNOTES

- ① VIDEO WALL DISPLAYS ON WALL MOUNT SYSTEM
- ② SURFACE MOUNTED LOUDSPEAKER
- ③ PAN/TILT/ZOOM CAMERA ON WALL MOUNT BRACKET
- ④ FLAT PANEL DISPLAY ON DUAL SWING ARM WALL MOUNT
- ⑤ EQUIPMENT ACCESS HATCH FLUSH MOUNTED IN RAISED ACCESS FLOOR
- ⑥ COLLECTOR/JUNCTION BOX MOUNTED ON SLAB BELOW ACCESS FLOOR - (SIZE T.B.D.)
- ⑦ EQUIPMENT RACK IN OFE CABINET
- ⑧ 2-GANG J-BOX FOR AV EQUIPMENT MOUNTED IN OFE MILLWORK @ 18" A.F.F.
- ⑨ OFE CABINET

FLOOR PLAN DIAGRAM LEGEND

- H_W 1-GANG J-BOX FOR VIDEO WALL DISPLAY COAX/DATA DROP
- H_S 1-GANG J-BOX FOR WALL MOUNTED LOUDSPEAKER
- H_{TV} 1-GANG J-BOX FOR WALL MOUNTED DISPLAY COAX/DATA DROP
- 3/4" CONDUIT STUB TO ACCESSIBLE CEILING
- H_{AV} 2-GANG J-BOX FOR AV EQUIPMENT
- H_C 1-GANG J-BOX FOR PTZ CAMERA



REVISIONS


NO.	DATE	REV.	BY
1			
2			
3			
4			
5			
6			
7			
8			

Siskiyou County BOS
1312 Fairlane Road
Yreka, CA 96097

BOARDROOM & SOUND ROOM/FLOOR PLAN & RISER DIAGRAMS

JOB NUMBER: CA-22-025	BULLETIN:	SCALE: NTS	DATE: 09/25/2023
---------------------------------	-----------	----------------------	----------------------------

DESIGNED BY: MM	DRAWN BY: SLA	REVIEWED BY: MM
---------------------------	-------------------------	---------------------------

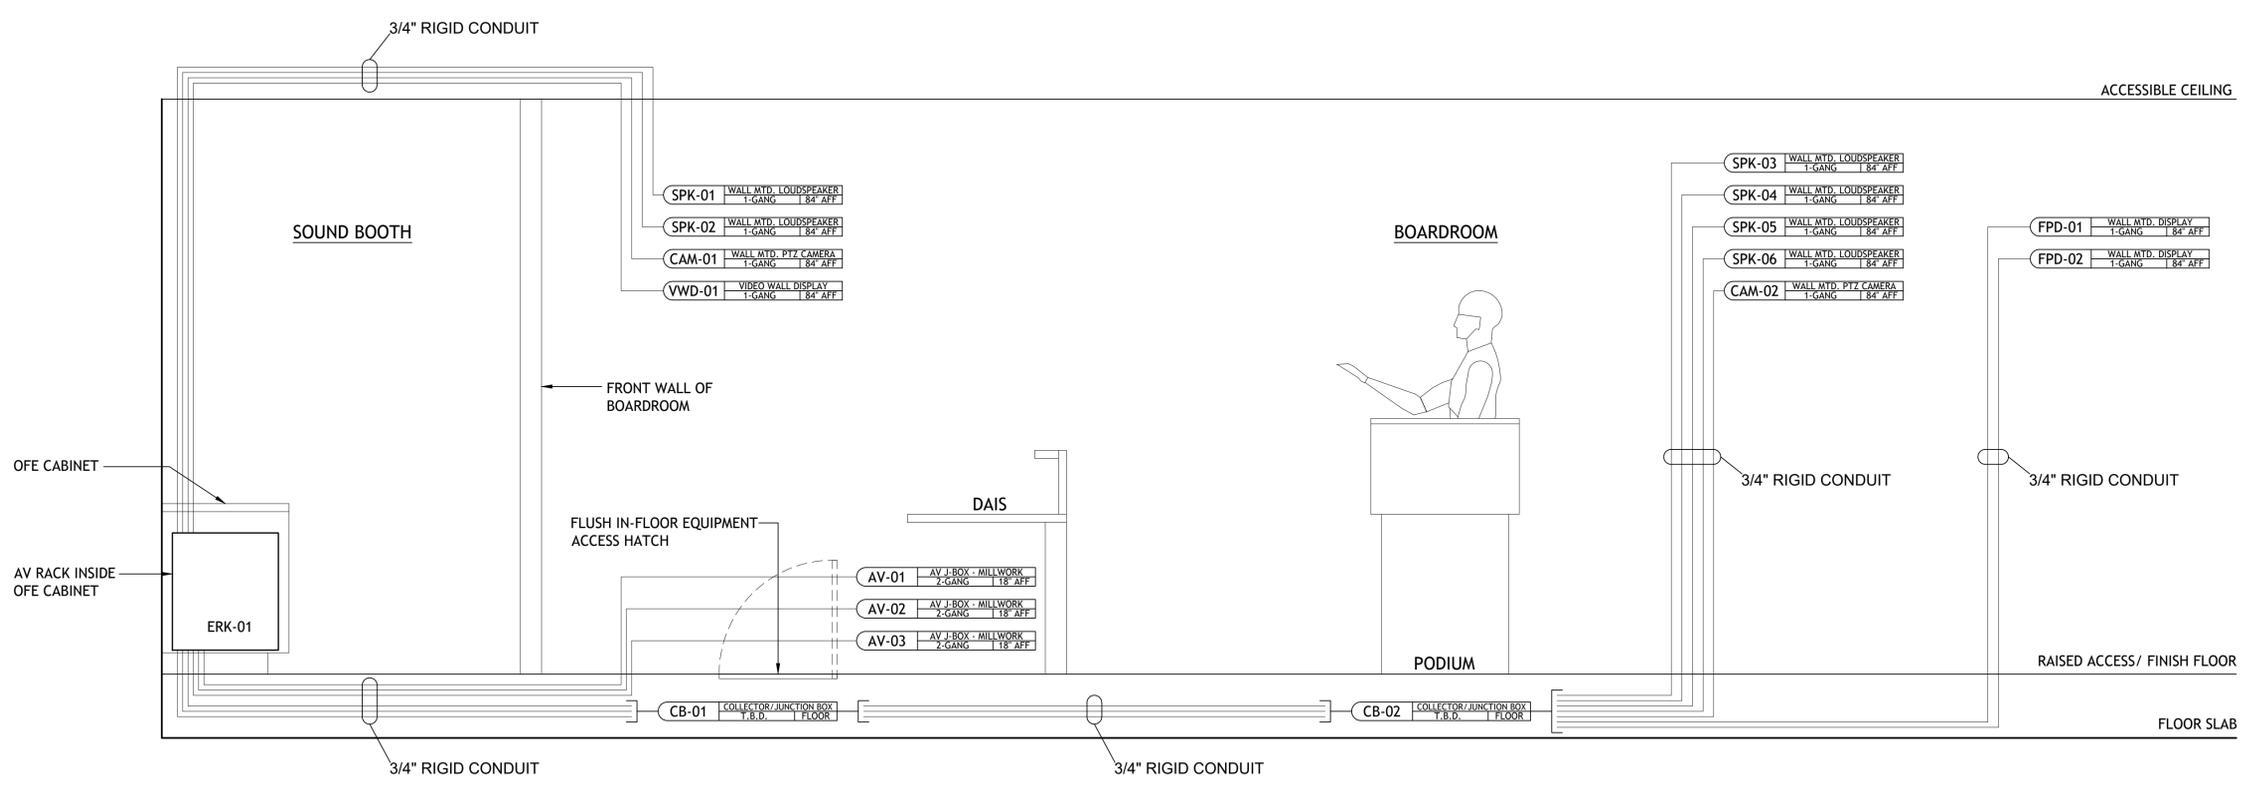

2 BOARDROOM & SOUND ROOM AUDIOVISUAL RISER DIAGRAM
SCALE: NOT TO SCALE



Siskiyou County

INVOICE

806 South Main Street Yreka, CA 96097
530-841-2100
<https://www.co.siskiyou.ca.us/>

Date: 09/21/2023

SISKIYOU CO OF COURT HOUSE
UNKNOWN
UNKNOWN, XX 00000

Application No.: B230217
Project: LOG 34350
Permit Type: COMMERCIAL
Site Address: 311 FOURTH ST YREKA CA 96097

Parcel No.: 054181010000

Subdivision:

Description	Fee Amount	Paid/Credit	Balance Due
Electrical Permit Issuance	\$7.25		\$7.25
Mechanical Permit Issuance	\$7.25		\$7.25
Building Permit	\$1,329.75		\$1,329.75
California Building Standards Code Fee	\$6.30		\$6.30
Electrical Permit	\$118.24		\$118.24
Plumbing Permit	\$29.10		\$29.10
Plumbing Plan Check Fee	\$7.28		\$7.28
Strong Motion Seismic Fee - Residential	\$0.00		\$0.00
Building Plan Check Fee	\$864.34		\$864.34
California Building Standards Code Fee	\$0.70		\$0.70
Mechanical Permit	\$7.25		\$7.25
Plumbing Permit Issuance	\$23.50		\$23.50
Strong Motion Seismic Fee - Residential	\$0.00		\$0.00
Mechanical Plan Check Fee	\$1.81		\$1.81
Electrical Plan Check Fee	\$29.56		\$29.56

Total Fee Amount:	\$2,432.33
Total Paid Credit:	\$0.00
Balance Due:	\$2,432.33

PAYMENT DUE UPON RECEIPT

Contacts:

Type	Name	Address
OWNER	SISKIYOU CO OF COURT HOUSE	UNKNOWN UNKNOWN, XX 00000
APPLICANT	SISKIYOU CO OF COURT HOUSE	UNKNOWN UNKNOWN, XX 00000

MARSHALL



Integration-Friendly Furniture®
Since 1986

Prairie ADA Style

Custom MLP-48ADA Lectern - MFI#38336RC - - Siskiyou County California BOS Chambers

Approximate Dimensions:
48"W x 38"-46"H x 32"D

Design Features Include:

- 8" Height Adjust with Lift Switch
- Open Knee Space for Wheelchair Users
- Space Atop Surface for User Speaker
- Microphone Cut Out (TBD)
- Black Exhaust Top Vent
- 1" Solid Wood Top Cap
- Surface Grommets as Needed
- Cable Cubby Cut Out (TBD)
- Slanted Work Surface with Pencil Stop
- Floor Access Openings
- Locking Removable Service Panels
- Locking Swivel Carpet Casters

Lead Time:

- 6 Weeks for a Qty (1)
- Production Requires PO, Approvals, & Equipment for Custom Fitting (if needed)
- Procurement Must Be Through Approved AV Integration Company or Contract Furniture Dealership of MFI's Choosing
- Formal Design Drawings Showing 2D & 3D Line Views of Design Will Be Provided Upon Bid Award to Approved MFI Dealer



Design Subject to Change After Bid Award
Color Renderings for Reference Only



Call (847) 395-9350 to Request a Quote

All Woods are Plain Sliced with Open Pore Finish- Printed Colors are Approximate - Custom Color Matching Available - Samples Available Upon Request

Standard Woods & Finishes



Premium Woods & Finishes



Ask about our FSC®
Certified Products
SCS-COC-004377 K

Marshall Furniture Inc ❖ www.marshallfurniture.com
999 Anita Avenue ❖ Antioch IL 60002 ❖ P 847-395-9350 ❖ F 847-395-9351

© Copyright 2023 All Rights Reserved, Marshall Furniture Inc.

